

WATER SERVICE RECORD

Name Leon Cormier & Sons, Inc.

Service No. 306

Address 21 Bellflower Street

Location

~~Repair~~ ~~Renewal~~ New Service

Amn 2-5-60

Date	Material	Amount	Total	Date	Amount
12-8-59	Labor	2.01		1-8-60	Deposit 50.00
	10% O.H.	.20	2.21	1-8-60	* Refund 20.16
50'	3/4" Copper tubing @.42		21.00		29.84
1	3/4" C x 1/2 I.W.H. Stop & Waste	5.88			NON CHARGE
1	hr. Trucking @.75	.75			Labor 1.61
			29.84	27'	3/4" Copper tubing @.42 11.34
				1	3/4" C Corp Cock 4.67
				1	3/4" C Curb Cock 5.98
				1	Box & Rod 5.00
				1	2/2" Straight tailpiece .50
				1	1/2" Offset tailpiece .50
					29.60


* Applied to SHCH # 237

DATE _____

TOWN OF LEXINGTON — BOARD OF PUBLIC WORKS

WATER DIVISION

Sketch of Service Here

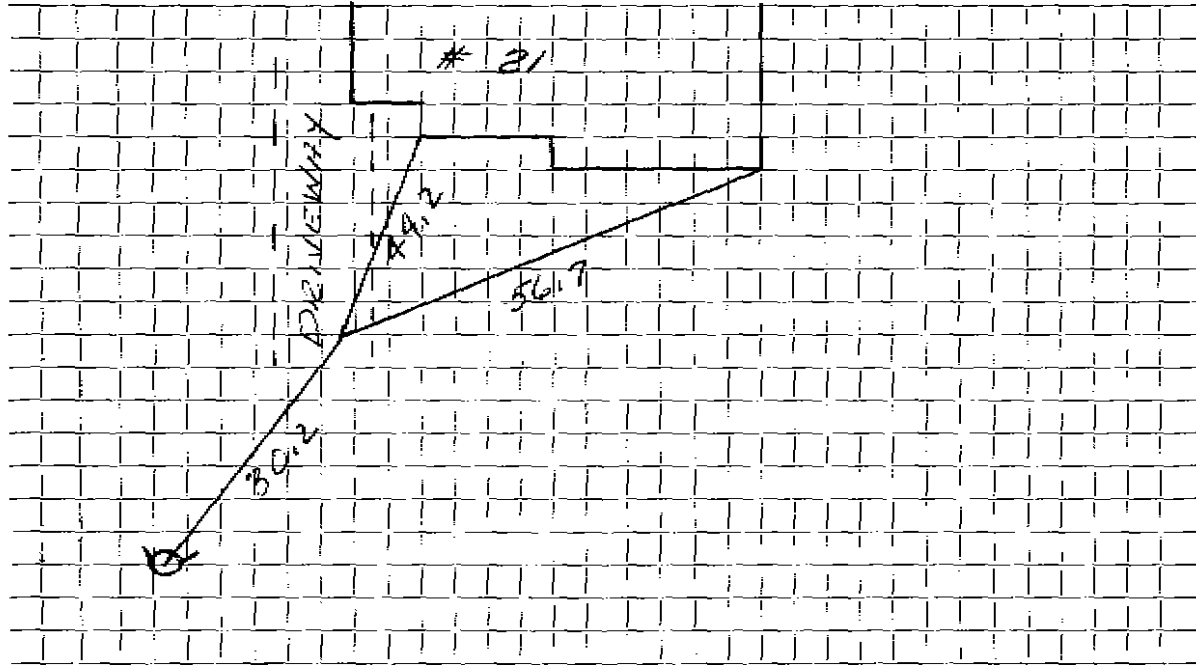

Connection made in Street. Work completed

Remarks:

.....
.....