

Name Francis Mollie

Service No. 236

Address 24 Bellflower St.

Location 24 Bellflower St.

Kind of Pipe

Size

Size of Main

Repair—~~Renewal~~ ~~New Service~~ 1" - McLaughlin #4367

Location

Date	Material	Amount	Total	Date	Amount
5/19/87	40' 1" Copper				
	1' 3/4" Copper				
	1 3/4 x 1" Union				
	1 1" Valve				
	Labor				

Hadley Franks, Inc., Lexington

DATE _____

TOWN OF LEXINGTON—BOARD OF PUBLIC WORKS

WATER DIVISION

The undersigned applies for a supply of water at No. _____ St. and hereby agrees to comply with the rules and regulations as now, or at any future time, established by the Board of Selectmen.

Am't. of Estimate \$ _____

Owner

Drew


Am't. Paid \$ _____

Address

24 Bellflower St.

Builder _____

Sketch of Service Here

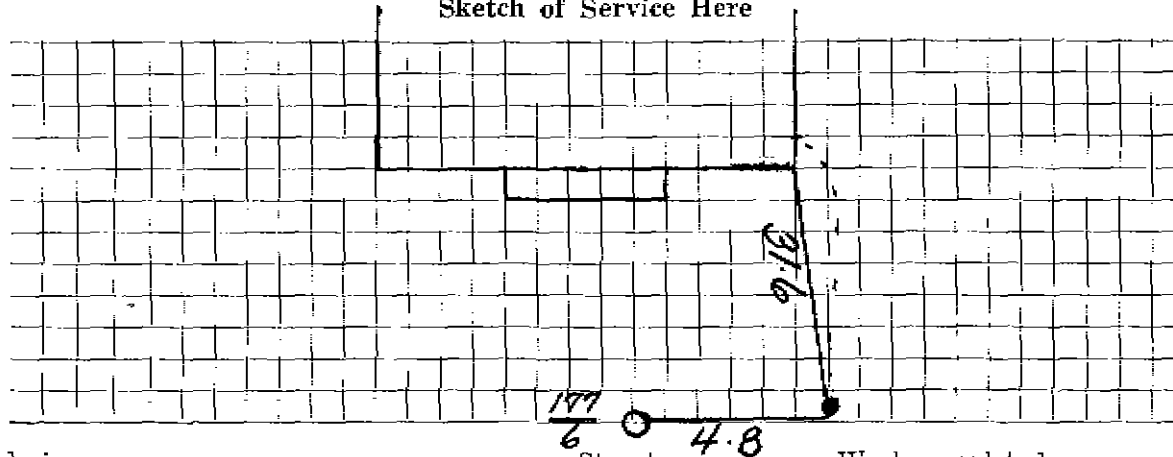

Connection made in _____

Street.

Work completed _____

19

Remarks: