

2905

WATER SERVICE RECORD

Name Leon Cormier & Sons, Inc.

Service No. 148

Address # 32 Belflower Street

#3568

Location


~~Repair - Renewal~~ New Service

Comm 10-19-59

Date	Material	Amount	Total	Date	Amount
7-17-59	Labor	4 02		7-1-59	25 00
	10% O. H.	40	4 42	10-19-59	6 75
45'	3/4" Copper tubing @.3764	20 70			31 75
1	3/4" C x 1/2" T.WH. Stop & Waste	5 88			<u>NON CHARGE</u>
1	Hr. Trucking @.75		22 75	7-17-59	Labor 3 90
			31 75		
				20'	3/4" Copper tubing @ 3764 7 53
				1	3/4" C Corp Cock 4 67
				2	3/4" C Curb Cock @6.07 12 14
				2	Box & Rods @5.00 10 00
				1	1/2" Straight Tailpiece 50
				1	1/2" Offset Tailpiece 50
					<u>39 24</u>

Remarks:

Connection made in Belflower Street. Work completed

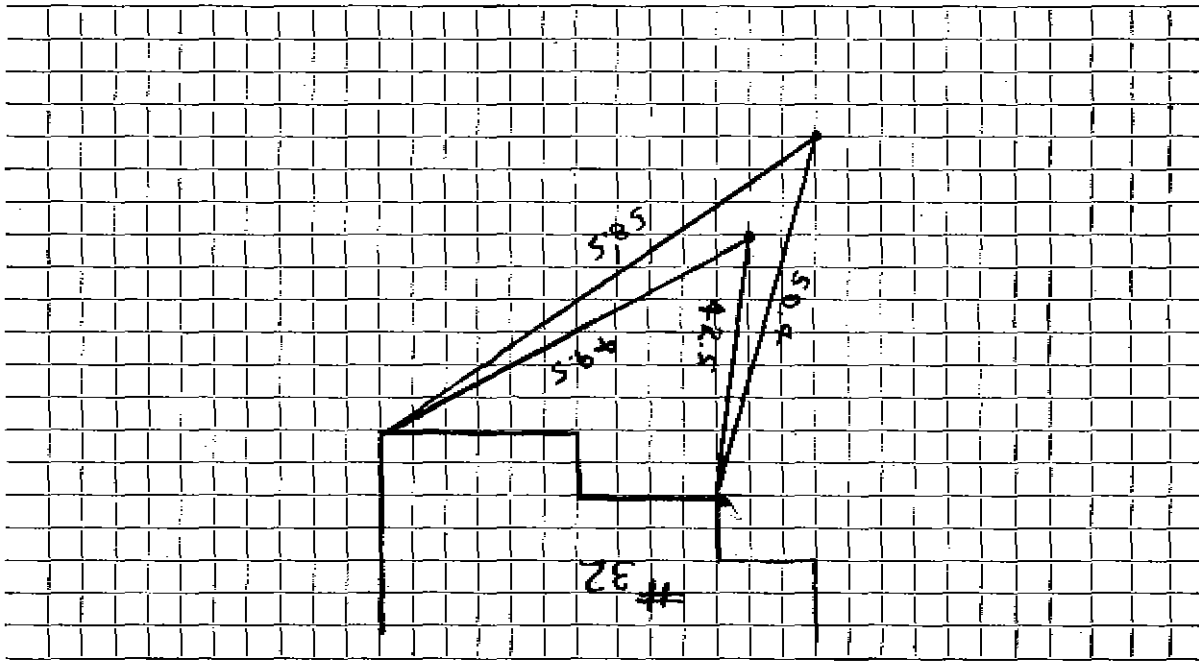

Sketch of Service Here

WATER DIVISION

TOWN OF LEXINGTON — BOARD OF PUBLIC WORKS

DATE 20.6.59