

WATER SERVICE RECORD

Name Richard H. Soule

Service No. 281

Address 33 Bellflower Street

1905

Location

3781

~~Repair or Renewal~~ - New Service

Comm. 12-19-55

Date	Material	Amount	Total	Date	Amount
10/2/55	Labor	5 05		8-24-55	60 00
	20% overhead	51	5 56	12-19-55	9 69
	50' - 3/4" copper tubing @ .56	28 00			50 31
	1 - 3/40 x 1/2 I.W.F. Stop & Waste	4 00			
	1 Hr. trucking		75		
	1 2/3 hrs. Littlefield Sh.	77.50	12 30		
			50 31		
				Labor	5 05
				15' 3/8" copper tubing @ .56	8 40
				1 - 3/4 G. Corp Cock	1 23
				1 - 3/4 G. Corp Cock	1 67
				1 Box & Rod	3 90
				2 - 1" Straight tail piece	50
				1 - 1" Offset tail piece	50
					27 35


Deposited
Refunded
NOA-CHARGE

DATE _____

TOWN OF LEXINGTON — BOARD OF PUBLIC WORKS

WATER DIVISION

Sketch of Service Here

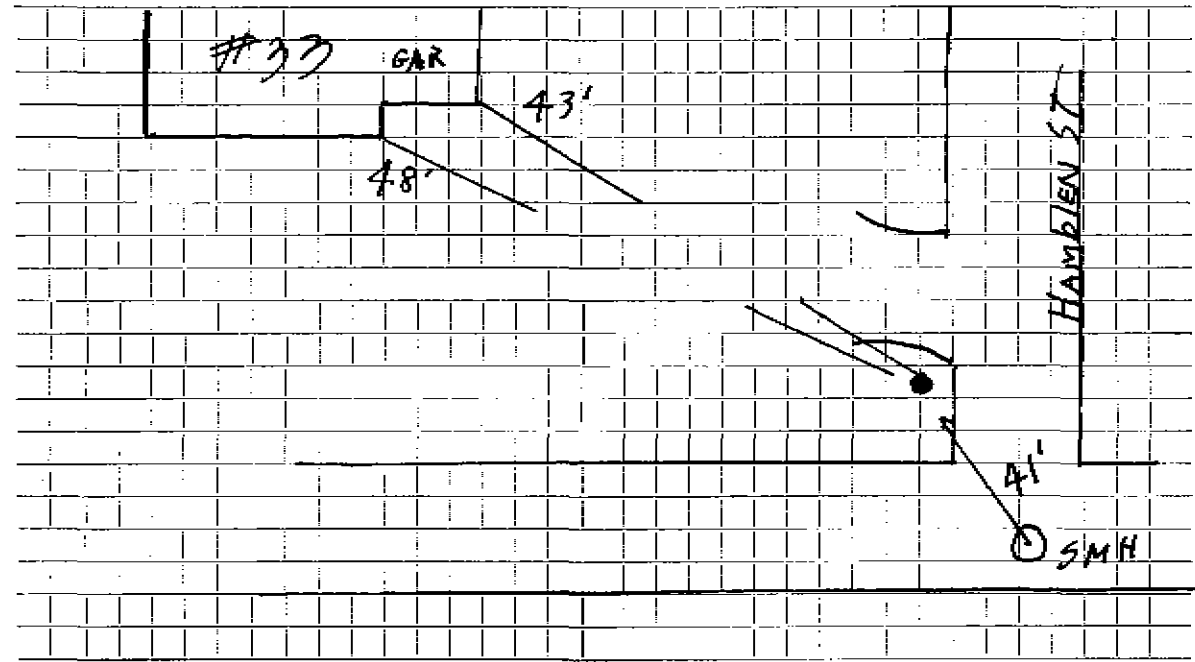

Connection made in Street. Work completed

Remarks:
.....
.....