




DATE 20-6-59

TOWN OF LEXINGTON — BOARD OF PUBLIC WORKS

WATER DIVISION

Sketch of Service Here

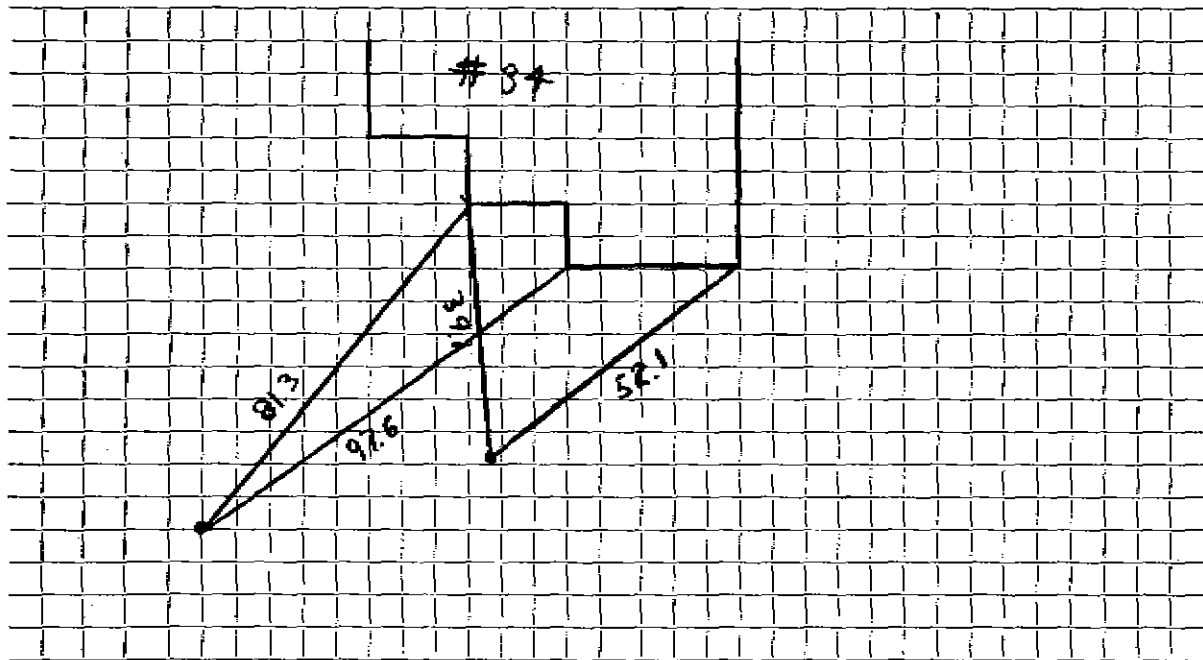

Connection made in Belflower Street. Work completed

Remarks: