

WATER SERVICE RECORD

Name Leland Const. Co.

Service No. 52A

Address 7 Bellflower Street

# 5442

Location Lexington

Repair—Renewal—New Service


*Com. 6-16-52*

Date	Material	Amount	Total	Date	Amount
5/13/52	Labor	3 76		4-15-52 Deposited	45 00
	10% overhead	38	4 14	6-16-52 Refunded	(2 36)
	40' - 3/4" copper tubing@.3439	13 75			37 00
	1 - 3/4" C x 3/4" I.W.H. stop&waste	4 00		5/15/52 Labor	11 14
	3 hrs. town shovel@ 5.00	15 00		28' - 3/4" copper tubing@.3439	9 62
	1 hr. trucking		75	1 - 3/4" C. corp-cock	4 33
			37 64	1 - 3/4" C x 3/4" C. curb-cock	4 67
				1 box and rod	4 62
				1 - 1/2" straight tail piece	50
				1 - 1/2" offset tail piece	50
				2 hrs. town shovel@ 5.00	10 00
				1 hr. trucking	75
					46 03

TOWN OF LEXINGTON — BOARD OF PUBLIC WORKS

**WATER DIVISION**

Sketch of Service Here

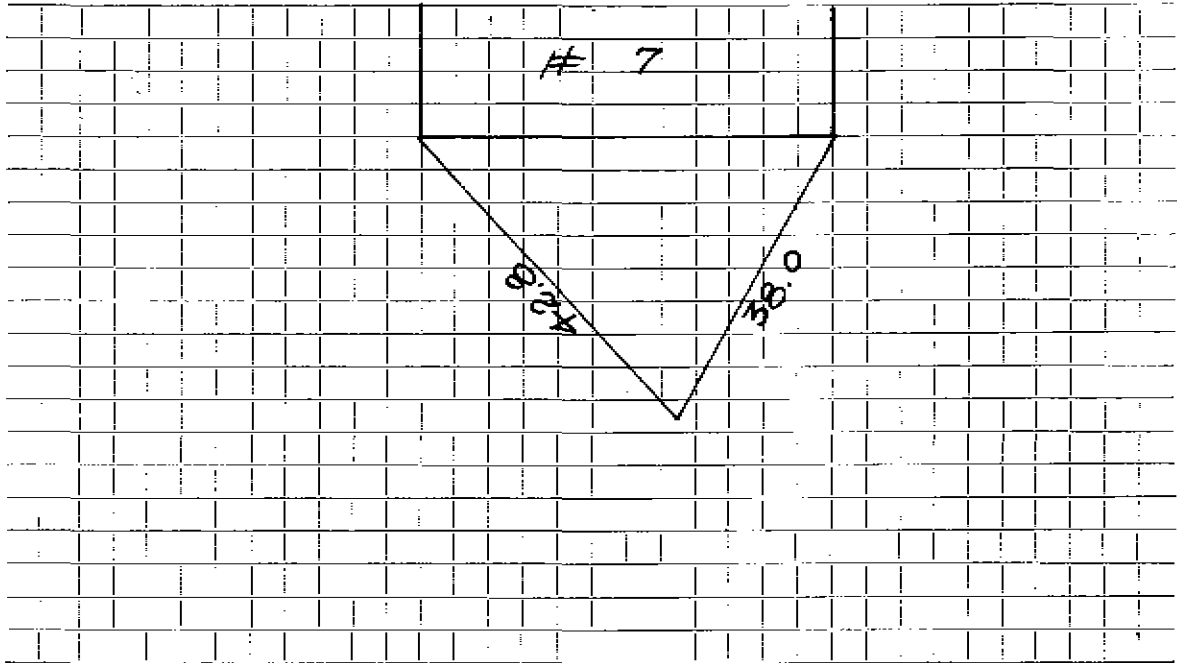

Connection made in ..... Street.                      Work completed .....

Remarks: .....  
.....  
.....