

WATER SERVICE RECORD

Name Leland Const. Co.

Service No. 52A

Address 8 Bellflower Street

1985

Location Lexington

Repair - Renewal - New Service

Com. 6-16-52


Date	Material	Amount	Total	Date	Amount
5/13/52	Labor	3 75		4-15-52 Deposited	45 00
	10% overhead	38	4 13	6-16-52 Refunded	6 68
	42' - 3/4" copper tubing @ .3439-14	44			<u>38 32</u>
	1 - 3/4" Cx 1/2 I.W.H. stop & waste	4 00		3/15/52 Labor	11 14
	3 hrs. town shovel @ 5.00	15 00		12' - 3/4" copper tubing @ .3439	4 13
	1 hr. trucking		75	1 - 3/4" C. corp-cock	4 33
			38 32	1 - 3/4" C x 3/4" C. curb-cock	4 67
				1 - box end rod	4 52
				1 - 1/2 straight tail piece	50
				1 - 1/2 offset tail piece	50
				1 hr. town shovel	5 00
				1 hr. trucking	75
					<u>35 54</u>

DATE _____

TOWN OF LEXINGTON — BOARD OF PUBLIC WORKS

WATER DIVISION

Sketch of Service Here

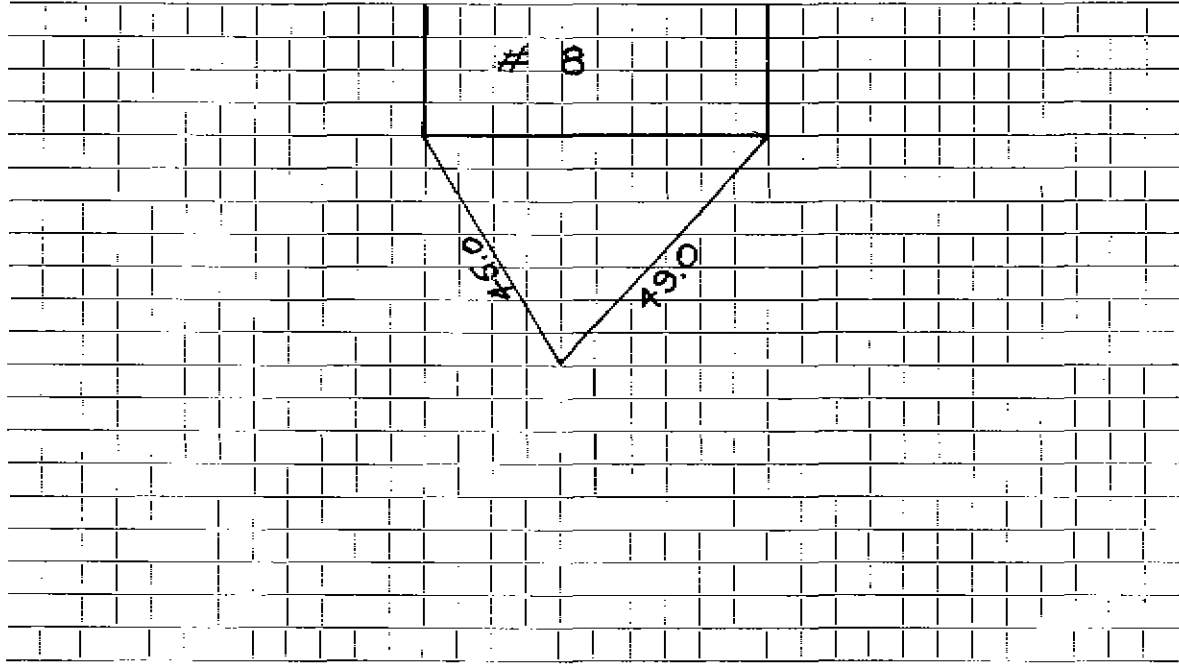

Connection made in Street. Work completed

Remarks:
.....
.....