

WATER SERVICE RECORD

3667

6670

Service No.

59

Name Ernest Outhet

Address 1 Benjamin Road

Location

Cam. 4-27-53

~~Repair - Renewal~~ - New Service

SERVICE WAS IN TO CURB

Date	Material	Amount	Total	Date	Amount
3/27/53	Labor	8 82		3-24-53	40 —
	10% Overhead	88	9 70	5-11-53	6 43
	72' - 3/4" Copper tubing @ .34		24 48		NON CHARGE
	1 - 3/4" C x 1/2 I.W.H. stop & waste		4 00	1 - 1/2	straight tail piece
	1 hr. Littlefield shovel		7 50	1 - 1/2	offset tail piece
	1 hr. trucking		75		50
			46 43		1 00

PART OF TRENCH DUG BY OWNER


4-27-53

DATE _____

TOWN OF LEXINGTON — BOARD OF PUBLIC WORKS

WATER DIVISION

Sketch of Service Here

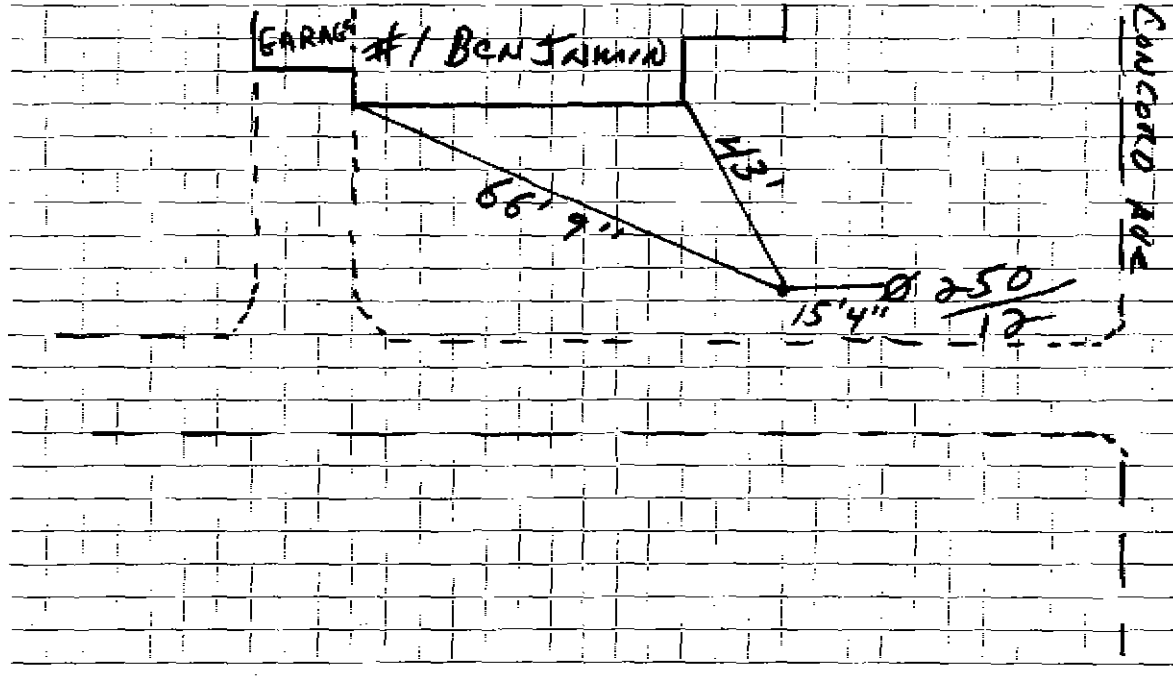

Connection made in Street. Work completed

Remarks:
.....
.....