

WATER SERVICE RECORD

Name R. J. Frissore Service No. 214

Address 11 Benjamin Road

Location \_\_\_\_\_

Repair ~~General~~ New Service *Cam 10-5-53*


Date	Material	Amount	Total	Date	Amount
8/7/53	Labor	6 25		7-29-53	Deposited 50 00
9/8/53	"	3 25	9 50	10-5-53	Refunded (13 12)
	10% overhead		95		NON CHARGE 36 88
	55' -3/4" copper tubing	3.3629	19 96		SERVICE WAS IN TO CURB:
	1 -3/4"C x 1/2 I.W.H. stop& waste	4 00			1 -1/2 straight tail pc. 50
	1 -3/4"C x 3/4"C. union	1 72			1 -1/2 offset tail pc. 50
	1 hr. trucking		75		1 00
			36 88		
	TRENCH DUG BY OWNER:				NON CHARGE
				3/21/52	Labor 3 42
					22' 3/4" copper tubing @ .3439 7 56
					1 3/4" C. corp cock 4 33
					1 3/4" C x 3/4" C curb cock 4 67
					1 box and rod 4 52
					1 hr. trucking 75
					25 25

DATE \_\_\_\_\_

TOWN OF LEXINGTON — BOARD OF PUBLIC WORKS

WATER DIVISION

Sketch of Service Here

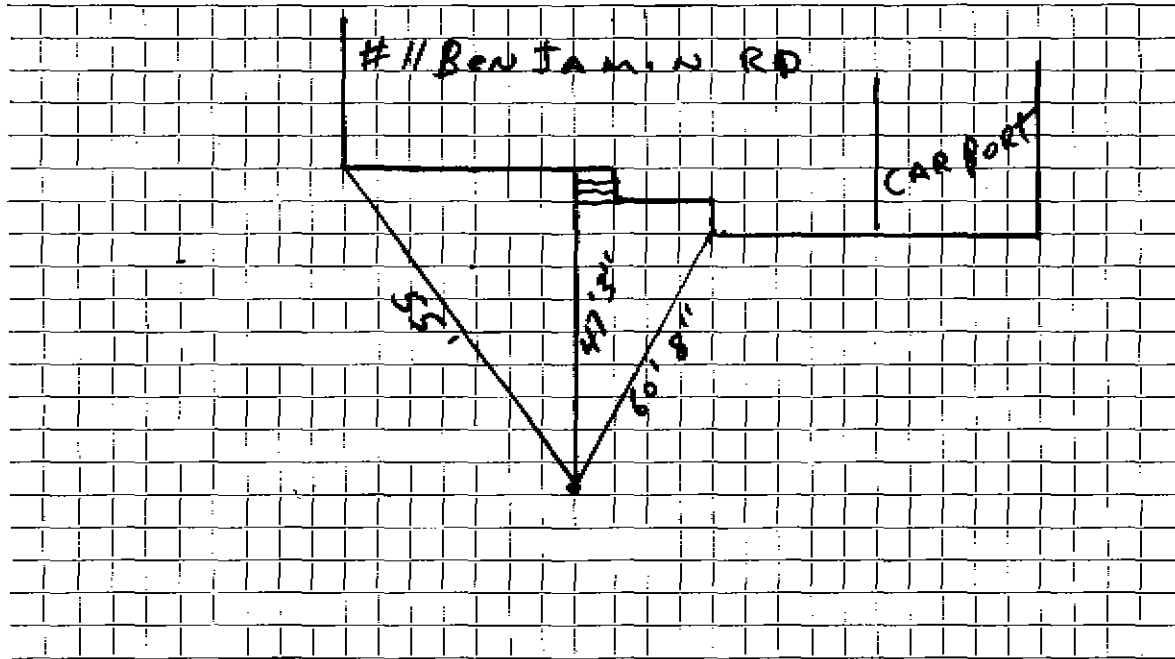

Connection made in ..... Street: ..... Work completed .....

Remarks: .....

.....

.....