

WATER SERVICE RECORD

2702

Name A. J. Parece, Jr.

Service No. 148

Address 12 Benjamin Road

Location

~~Repair~~ ~~Renewal~~ - New Service

Conn. 7-18-55


Date	Material	Amount	Total	Date	Amount
6/3/55	Labor	6 73		5-26-55	Deposited 75 00
	10% overhead	67	7 40	7-18-55	Refunded (93 57)
n.c.	36' - 3/4" copper tubing supplied by owner				NON CHARGE 41 43
	34' - 3/4" copper tubing @ .3693		12 56		
	1 - 3/4" C x 1/2 I.W.H. stop & waste		4 00		SERVICE WAS IN TO CURB:
	1 - 3/4" C. union		1 72	1 - 1/2 offset tail pc.	50
	2 hrs. Littlefield shovel @ 7.50		15 00	1 - 1/2 straight tail pc.	50
	1 hr. trucking		75		1 00
			41 43		NONCHARGE
				3/21/52 Labor	3 41
				13' 3/4" copper tubing @ .3439	4 47
				1 3/4" C. corp cock	4 33
				1 3/4" C x 3/4" C. curb cock	4 67
				1 box and rod	4 52
				1 hr. trucking	75
					22 15

DATE _____

TOWN OF LEXINGTON — BOARD OF PUBLIC WORKS

WATER DIVISION

Sketch of Service Here

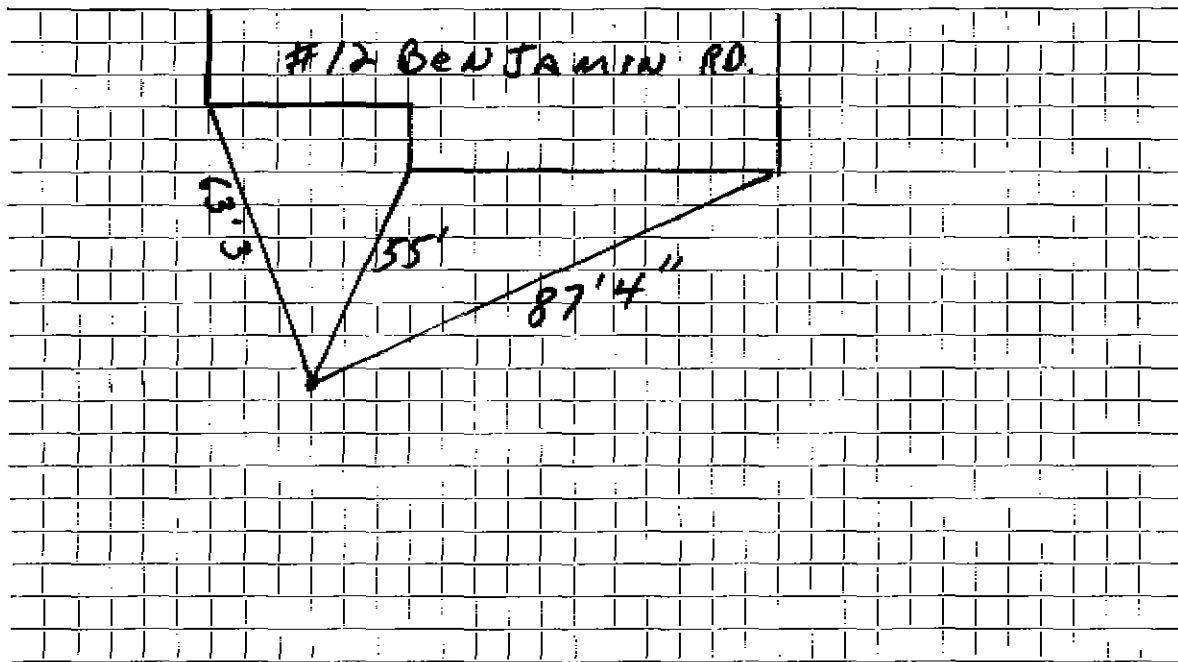

Connection made in _____ Street _____ Work completed _____

Remarks: _____

