

WATER SERVICE RECORD

#5651

Name Simeon DeMone

Service No. 387

Address 14 Benjamin Rd.

Location Lexington

~~Repair~~ ~~Renewal~~ New Service

*Conn. 12-21-53*

SERVICE WAS INTO CURB

Date	Material	Amount	Total	Date	Amount
12/7/53	Labor	16 67		12-8-53	Deposited 50 00
	10% overhead	1 67	18 34	1-5-53	Paid 13 04
	61'-3/4" Copper tubing @ .3629		23 23		NON CHARGE 63 04
	1-3/4" C x 1/2 I.W.H. STOP & WASTE		4 00	1-3/8 offset tail piece	50
	1-3/4" C x 3/4" C. Union (3 parts)		1 72	1-1/2 straight tail piece	50
	2 Hr. Littlefield shovel @ 7.50		15 00		1 00
	1 Hr. trucking		75		NON CHARGE
			63 04	3/21/52	Labor 3 42
					13' 3/4" copper tubing @ 3439 4 47
					1 3/4" C. <del>cock</del> 4 33
					1 3/4" C x 3/4" C. curb cock 4 67
					1 box and rod 4 52
					1 hr. trucking 75
					22 16


*bill sent 12 21-53*

DATE \_\_\_\_\_

TOWN OF LEXINGTON — BOARD OF PUBLIC WORKS

**WATER DIVISION**

Sketch of Service Here

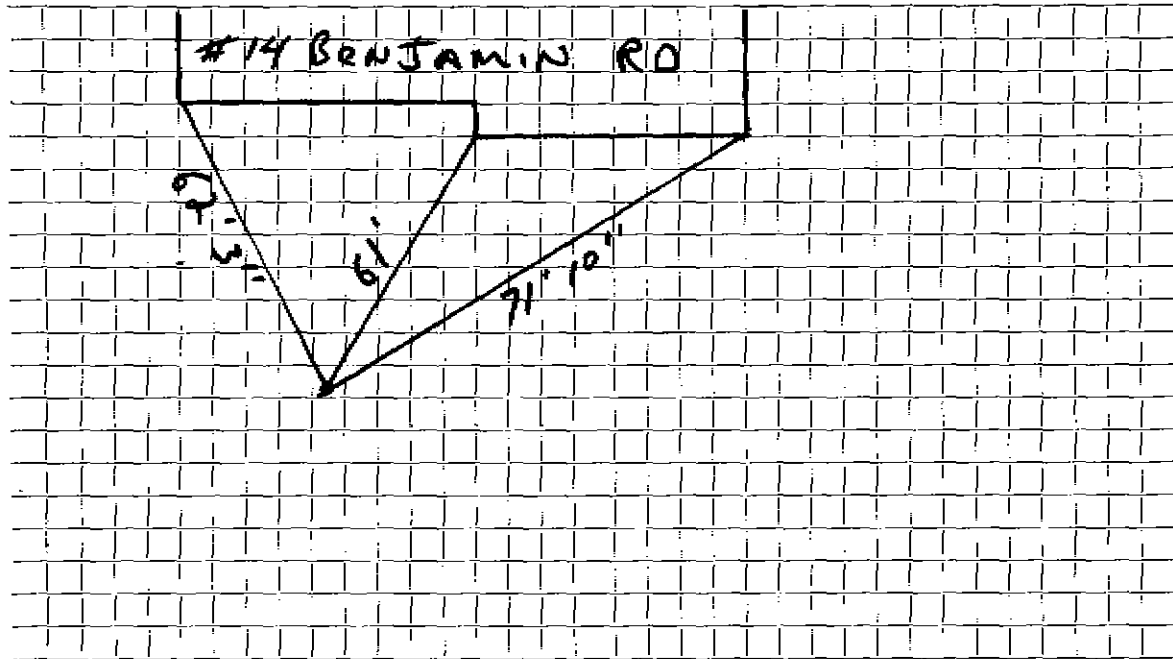

Connection made in ..... Street. Work completed .....

Remarks: .....

.....

.....