

WATER SERVICE RECORD

Name Clinton A. Coolidge

Service No.

247

Address 15 Benjamin Road

Location

~~Repair - Repair~~ - New Service

Service was into Curb

Comm. 11-19-56


Date	Material	Amount	Total	Date	Amount
7/23/56	Labor	16 80		8-20-56	Deposit 100 00
	10% Overhead	1 68	18 48	11-19-56	Refund 8 72
	55'-3/4" Copper tubing @.4850	26 68			NON CHARGE 91 28
	1-3/4" C x 1/2" I.W.H. Stop & Waste	4 96		1/2" Straight Tail Piece	50
	2 hr. Trucking @.75	1 50		1-1/2" Offset Tail Piece	50
	4 2/3 hrs. Littlefield Shovel	39 66			1 00
			91 28		
					NON CHARGE
				3/21/52	Labor 3 42
				24'	3/4" coppre tubing @ .3439 8 25
				1	3/4" C. corp cock 4 33
				1	3/4" C x 3/4" C curb cock 4 67
				1	box and rod 4 52
				1	hr. trucking 75
					25 94

DATE _____

TOWN OF LEXINGTON — BOARD OF PUBLIC WORKS

WATER DIVISION

Sketch of Service Here

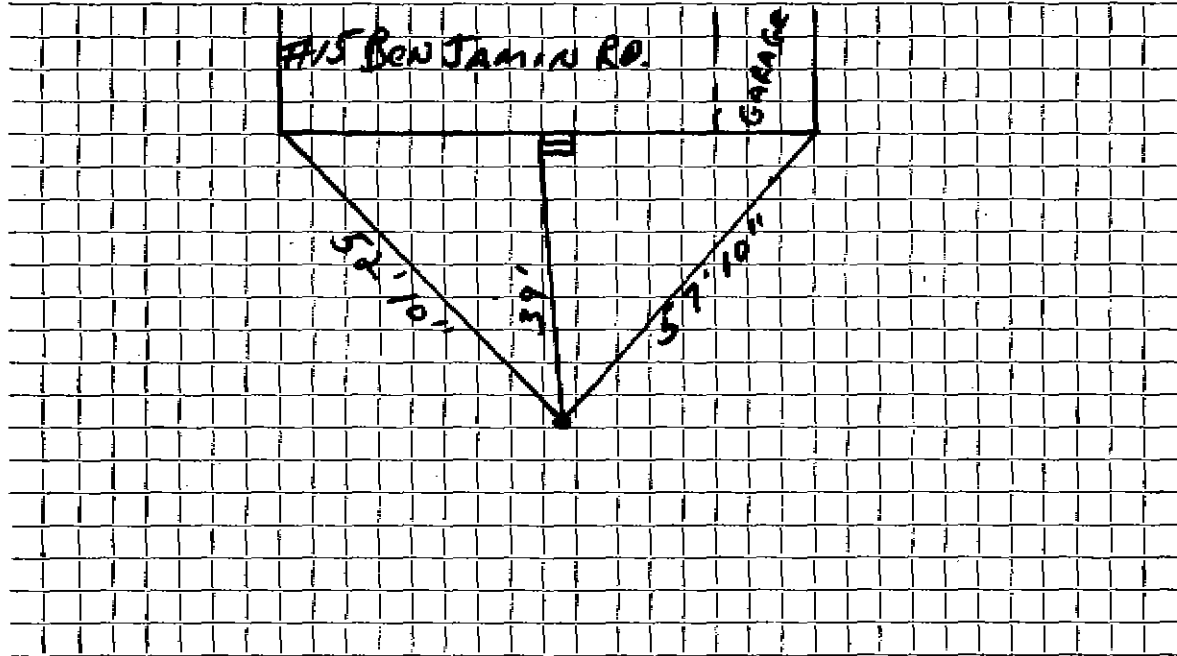

Connection made in Street. Work completed

Remarks:

.....

.....