

WATER SERVICE RECORD

Name **R. J. Frissore**

Service No. 382

Address **17 Benjamin Road**

7260

Location

Com. 12-21-53

~~Repair Service~~ New Service

SERVICE WAS IN TO CURB

Date	Material	Amount	Total	Date	Amount
12/7/53	Labor	12 50		12-3-53	50 00
	10% Overhead	1 25	13 75	1-12-54	1 65
	50' - 3/4" Copper tubing @ .3629	18 15			NON CHARGE
	1 - 3/4" C x 1/2" I.W.H. stop & waste	4 00		1 - 1/2" offset tail piece	50
	2 hrs. Littlefield shovel	7.50	15 00	1 - 1/2" straight tail piece	50
	1 hr. trucking		75		1 00
			51 65		NON CHARGE
				3/21/52	Labor
					3 41
					24' 3/4" copper tubing @ .3439
					8 25
					1 3/4" corp cock C.
					4 33
					1 3/4" C x 3/4" X. curb cock
					4 67
					1 box and rod
					4 52
					1 hr. trucking
					75
					25 93


Bill sent 10 21-58

DATE _____

TOWN OF LEXINGTON — BOARD OF PUBLIC WORKS

WATER DIVISION

Sketch of Service Here

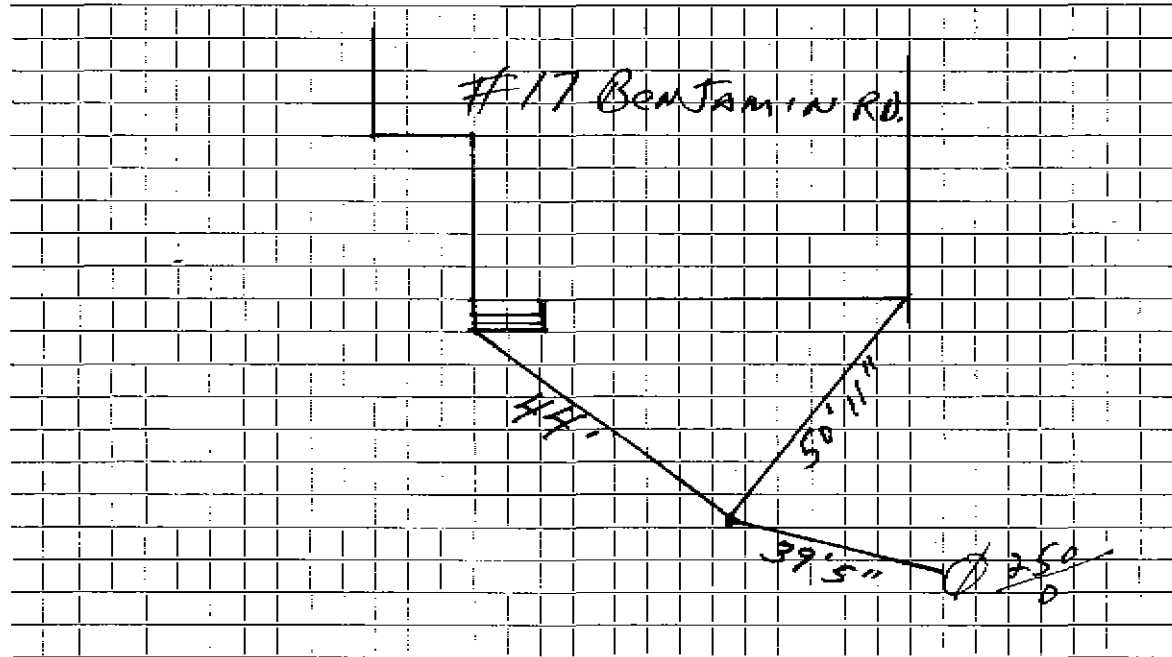

Connection made in Street. Work completed

Remarks:

.....

.....