

## WATER SERVICE RECORD

#844  
#845  
63

Name S. G. DeMone

Service No.

Address 18 Benjamin Road

Location Lexington

Repair ~~CHARGE~~ New Service

Com. 4-27-53


Date	Material	Amount	Total	Date	Amount
3/27/53	Labor	8 82		3-26-53	60 -
	10% overhead	88	9 70	4-27-53	(16 27
	42' - 3/4" copper tubing @ .34	14 28			NON CHARGE
	1 - 3/4" C x 1/2 I.W.H. stop & waste	4 00			service was in to curb:
	2 hrs. Littlefield shovel @ 7.50	15 00			1 - 1/2 straight tail piece
	1 hr. trucking		75		1 - 1/2 offset tail piece
			43 73		50
					1 00
					NON CHARGE
				4/11/52	Labor
					13' 3/4" copper tubing @ .3439
					1 3/4" C. corp cock
					1 3/4" C x 3/4" C. curb cock
					1 box and rod
					1 hr. trucking
					75.
					24 78

DATE \_\_\_\_\_

TOWN OF LEXINGTON — BOARD OF PUBLIC WORKS

**WATER DIVISION**

Sketch of Service Here

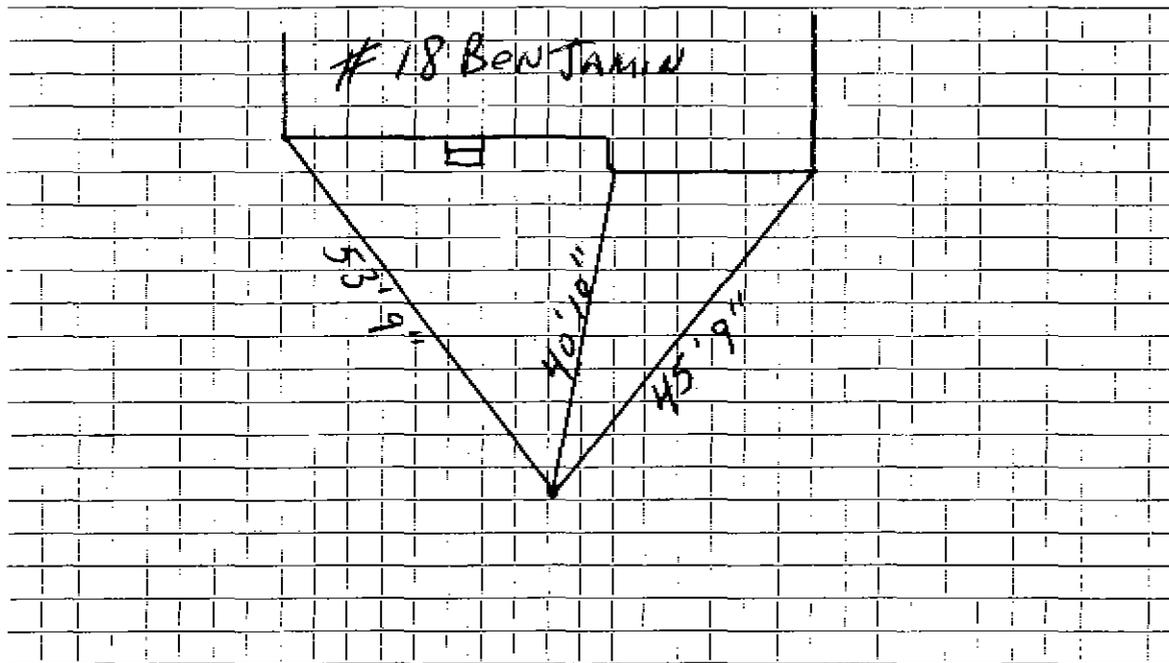

Connection made in ..... Street. Work completed .....

Remarks: .....

.....

.....