

WATER SERVICE RECORD

Name R. J. Frissore

Service No. 101

Address 19 Benjamin Rd.

Location Lexington

Repair ~~Renewal~~ - New Service

Can 7-13-53


Date	Material	Amount	Total	Date	Amount
5/21/53	Labor	6 25		5-15-53	50 00
	10% overhead	63	6 88	7-13-53	13 48
	47' 3/4" Copper Tubing @ .37		17 39		NON CHARGE
	1-3/4" C x 1/2" I.W.H. STOP & WASTE		4 00		86 52
	1 Hr. Littlefield Shovel		7 50	1-1/8" straight tail piece	50
	1 Hr. Trucking		75	1-3/8" offset tail piece	50
			36 52		1 00
					SERVICE WAS IN TO CURB:
					NON CHARGE
				4/14/52	Labor
					25' 3/4" copper tubing @ .3439
					1 3/4" C. corp cock
					1 3/4" C x 3/4" C. curb cock
					1 box and rod
					1 hr. trucking
					26 88

DATE _____

TOWN OF LEXINGTON — BOARD OF PUBLIC WORKS

WATER DIVISION

Sketch of Service Here

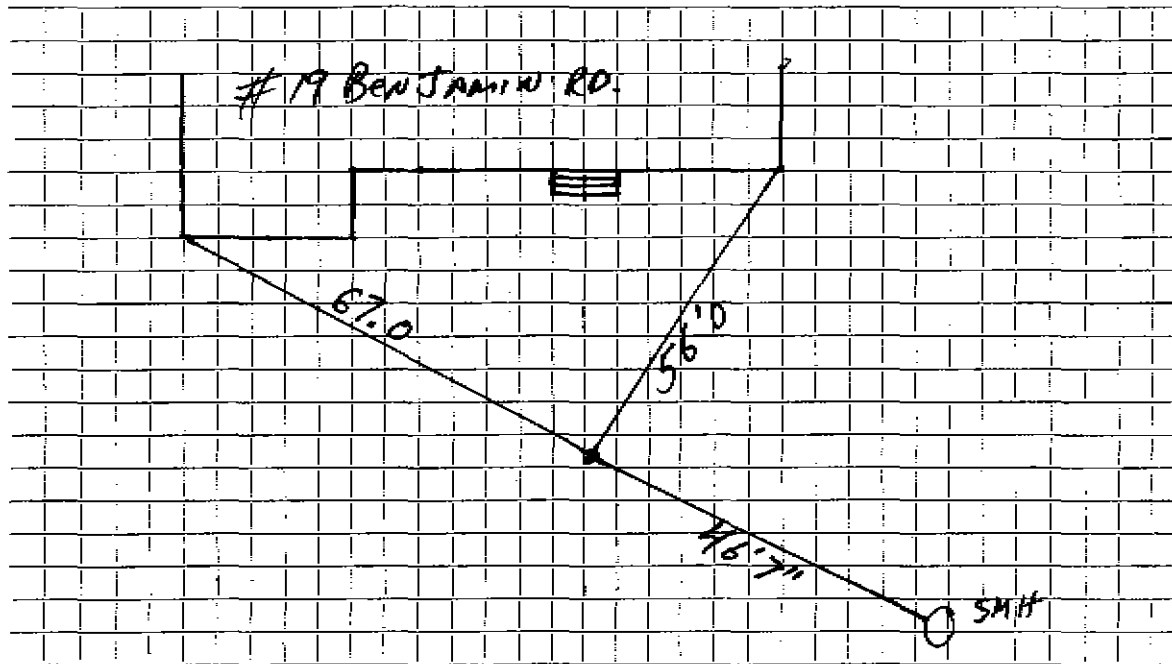

Connection made in Street. Work completed

Remarks:
.....
.....