
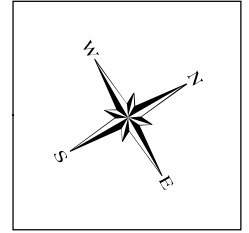


Water Service Tie Card
TOWN OF LEXINGTON
 MASSACHUSETTS

2 Benjamin Road

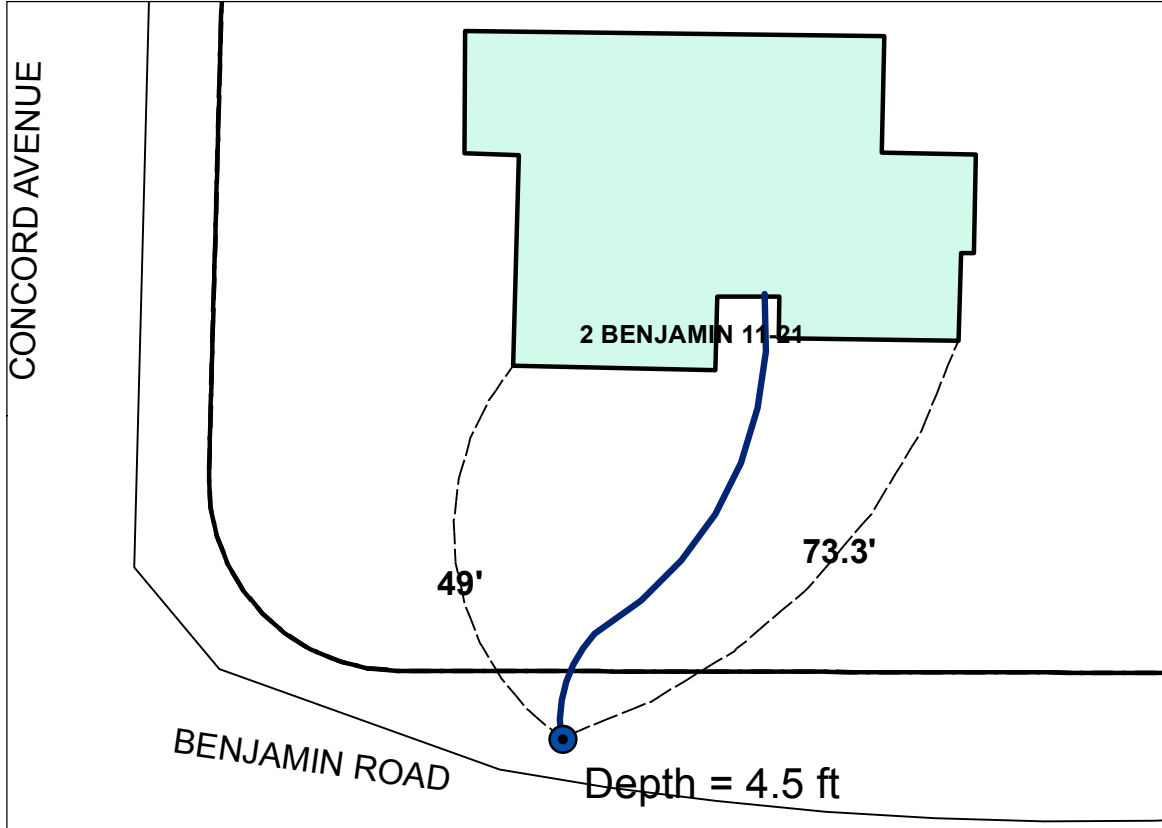

Legend	
●	Curb Stop
---	Ties_Dimensions
—	Water Service Line
---	Property Line
—	Edge of Pavement

Address	Map and Lot	Permit Number	Contractor Name	Inspector
2 Benjamin Road	11-21	5367	McLaughlin	D. Pavlik

Date: 5/23/13	Material	Amount
	1" Curb Stop	
	1" Copper type "k"	65 Feet

Type of work completed
 New 1" water service to house from curb stop. New house on lot old house removed.