

WATER SERVICE RECORD

Name Simeon Demona

Service No. 142

Address 20 Benjamin Road

554

Location Lexington

Report ~~Renewal~~ New Service COM. 9/8/52


Date	Material	Amount	Total	Date	Amount
8/4/52	Labor	8 82		7-11-52 Deposited	75 00
	10% overhead	88	9 70	9-10-52 Refunded	(15 01)
	70' - 3/4" copper tubing @ .326	22 82			59 99
	1 - 3/4" cx 1/2 I.W.H. stop & waste	4 00		4/15/52 Labor	3 02
	1 - 3/4" Cx 3/4" C. union 3 pts.	1 72		13' - 3/4" copper tubing @ .3439	4 47
	3 hrs. littlefield shovel	21 00		1 - 3/4" C. corp-cock	4 33
	1 hr. trucking	75		1 - 3/4" C x 3/4" C. curb-cock	4 67
			59 99	1 box and rod	4 52
				1 hr. trucking	75
					<u>21 76</u>
				8/4/52 1 - 1/2 straight tail piece	50
				1 - 1/2 offset tail piece	50
				TOTAL NON CHARGE:	<u>22 76</u>

DATE _____

TOWN OF LEXINGTON — BOARD OF PUBLIC WORKS

WATER DIVISION

Sketch of Service Here

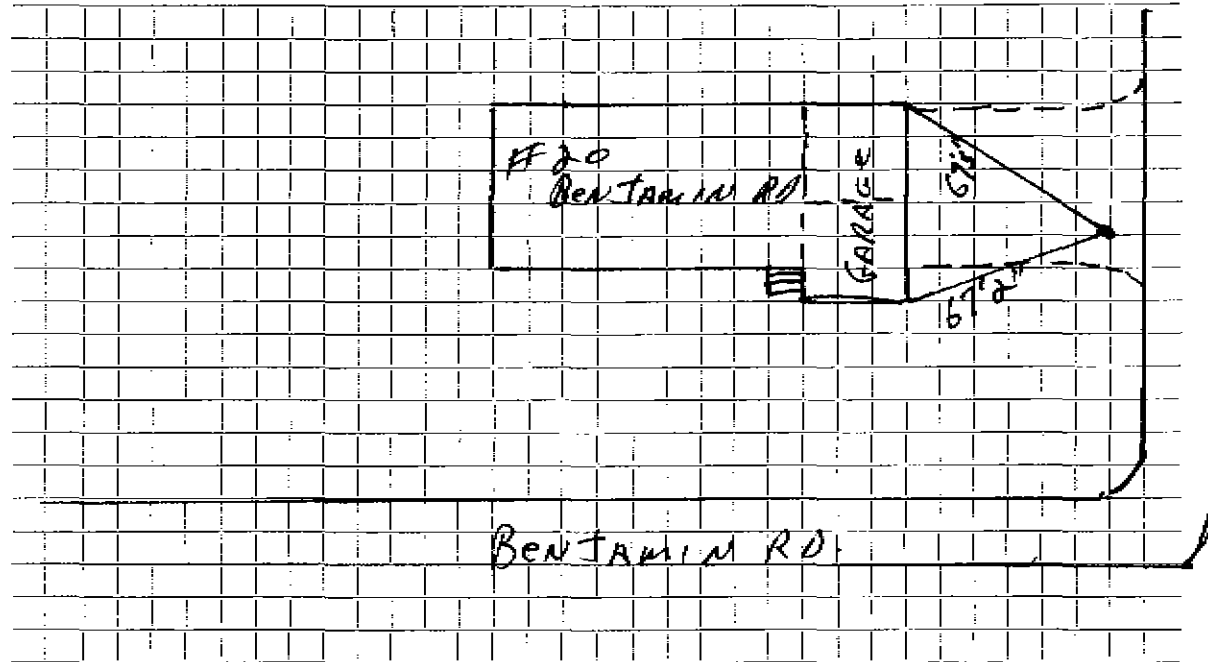

Connection made in _____ Street _____ Work completed _____

Remarks: _____
