

WATER SERVICE RECORD

1331

Service No. 178

Name S. A. Demone

Address 21 Benjamin Road

Location Lexington

*Com. 11-3-52*

~~Repair~~ ~~Renewal~~ — New Service


SERVICE WAS IN TO CURB

Date	Material	Amount	Total	Date	Amount
10/1/52	Labor	6 33		8-20-52	40 00
	10% Overhead	63	6 96	11-5-52	89
	60' - 3/4" Copper tubing @ .34	20 40		NON CHARGE	
	1 - 3/4" C x 1/2 I.W.H. stop & waste	4 00		1 - 1/2 offset tail piece	50
	1 hr. Littlefield shovel	7 00		1 - 1/2 straight tail piece	50
	1 hr. trucking		75		1 00
			39 11		
				NON CHARGE	
				4/14/52	Labor
					4 03
					27' 3/4" copper tubing @ .3439
					9 28
					1 3/4" C. corp cock
					4 33
					1 3/4" C x 3/4" C. curb cock
					4 67
					1 box and rod
					4 52
					1 hr. trucking
					75
					27 58

TOWN OF LEXINGTON — BOARD OF PUBLIC WORKS

**WATER DIVISION**

Sketch of Service Here

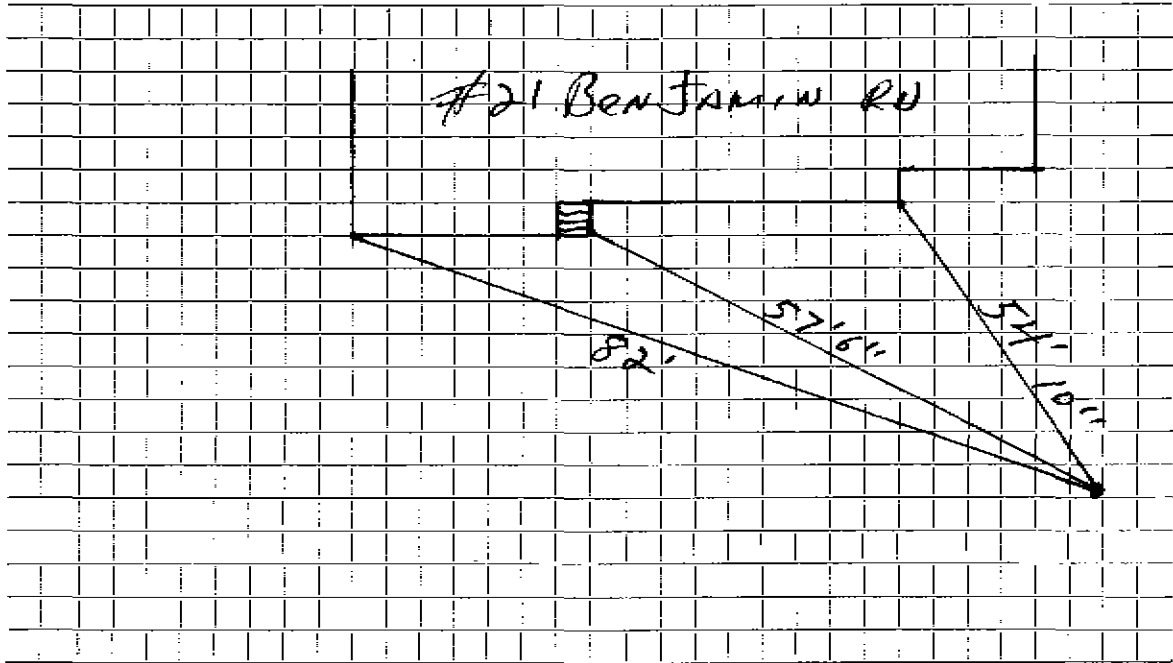

Connection made in ..... Street. Work completed .....

Remarks: .....  
.....  
.....