

#247

WATER SERVICE RECORD

Name Jack Williams

Service No. 248

Address ~~586 Cambridge-Concord Highway~~ 23 Benjamin Rd.

Location 8/14/70

REPAIR #4628 - New Service Com. 10-5-53


Date	Material	Amount	Total	Date	Amount
9/17/53	Labor	10 12		4-24-53 Deposited	5 00
	10% overhead	1 01	11 13	10-5-53 Refunded	10 67
	115' - 3/4" copper tubing @ .3629	41 73			<u>NON CHARGE</u>
	1 - 3/4"C x 1/2 I.W.H. stop & waste	4 00			SERVICE WAS IN TO CURB:
	1 - 3/4"C x 3/4"C. union	1 72		1 - 1/2 straight tail piece	50
	1 hr. trucking		75	1 - 1/2 offset tail piece	50
	2 hrs. Littlefield shovel @ 7.50		15 00		<u>1 00</u>
			74 33		
	Repair #4628 Redmond				
12/8/87	25' 3/4" Copper			4/14/52 Labor	4 03
	2 3/4" Comp. Unions			25' 3/4" copper tubing @ .3439	8 59
				1 3/4" C. corp cock	4 33
				1 3/4" C x 3/4"C curb cock	4 67
				1 box and rod	4 52
				1 hr. trucking	75
					<u>26 89</u>

DATE _____

TOWN OF LEXINGTON — BOARD OF PUBLIC WORKS

WATER DIVISION

Sketch of Service Here

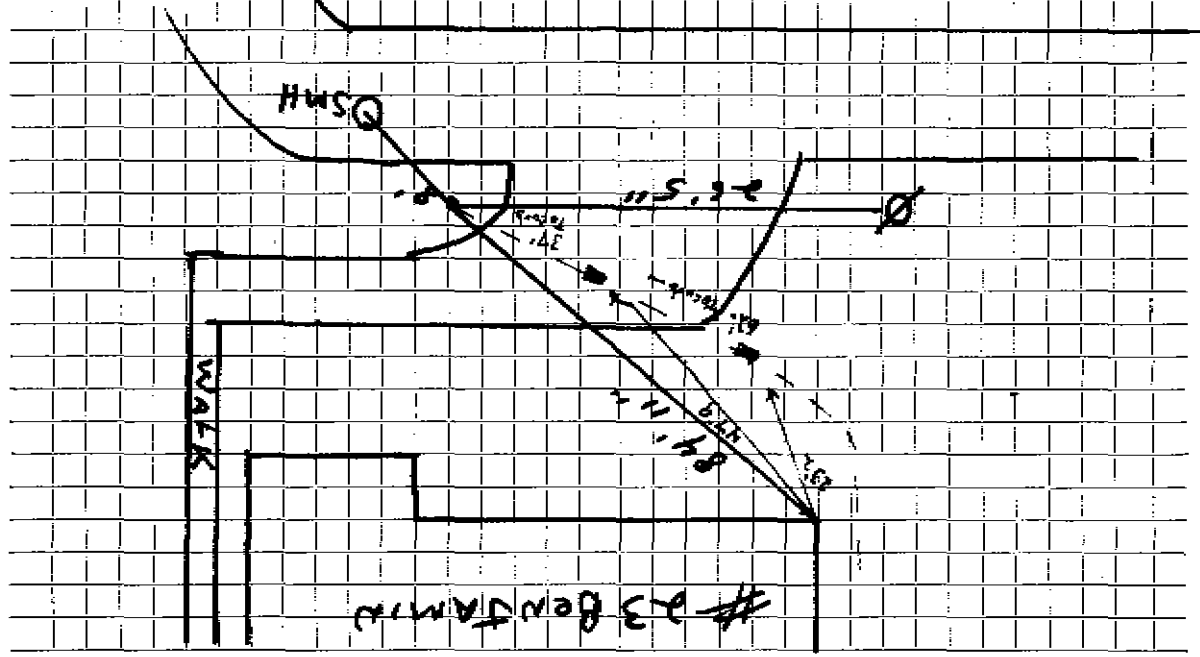

Work completed

Street.

Connection made in

Remarks: