

WATER SERVICE RECORD

2336

270

Name Francis V. Bagwell

Service No.

Address 5 Benjamin Road

Location

Com 11-9-53

~~Report of Renewal~~ - New Service

SERVICE WAS IN TO CURB


Date	Material	Amount	Total	Date	Amount
9/18/53	Labor	12 50		9-10-53 Deposited 11-9-53 Refunded	(30 00) 53
	10% Overhead	1 25	13 75	NON CHARGE	49 47
	44' - 3/4" Copper tubing @ .3429	15 97		1-1/2 offset tail piece	50
	1 - 3/4" C x 1/2 I.W.H. stop & waste	4 00		1-2 straight tail piece	50
	2 hrs. Littlefield shovel @ 7.50	15 00			1 50
	1 hr. trucking		75		
			49 47		
				NON CHARGE	
				3/21/52 Labor	3 41
				25' 3/4" copper tubing @ .3439	8 60
				1 3/4" C. corp cock	4 33
				1 3/4" C. x 3/4" C. curb cock	4 67
				1 Box and rod	4 52
				1 hr. trucking	75
					26 28

DATE _____

TOWN OF LEXINGTON — BOARD OF PUBLIC WORKS

WATER DIVISION

Sketch of Service Here

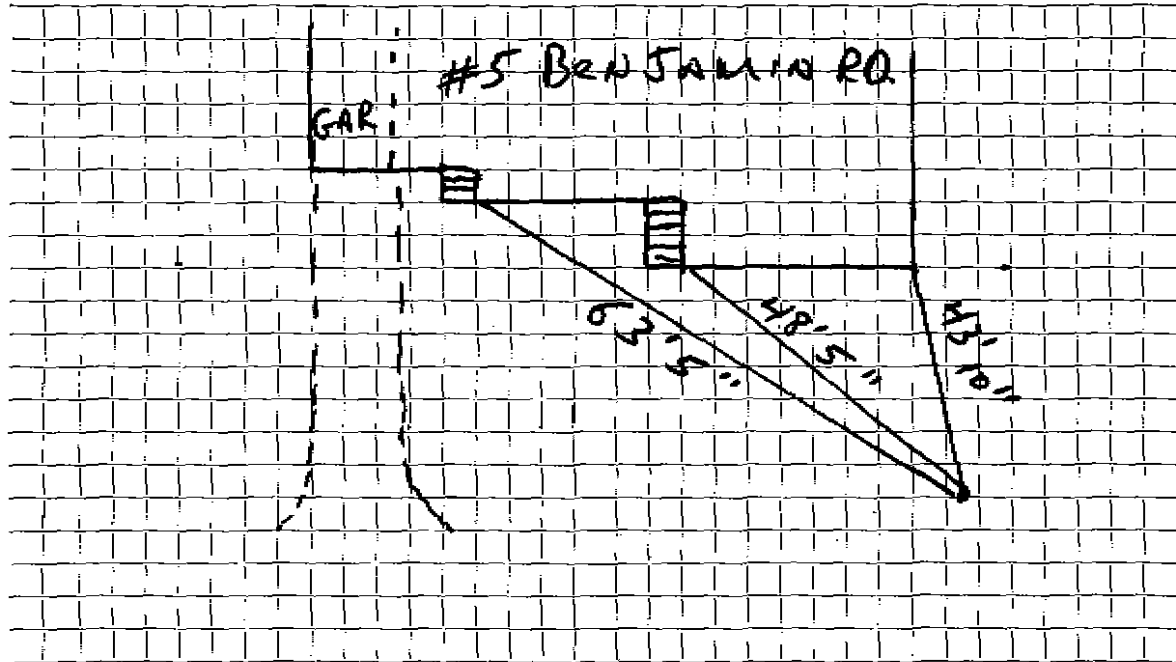

Connection made in _____ Street. Work completed _____

Remarks: _____

