

WATER SERVICE RECORD

Name Joseph E. Duffy

Service No. 129

Address 7 Benjamin Road

#6380

Location

#7412

~~Repair~~ ~~Renewal~~ - New Service


Comm. 10-28-57

Date	Material	Amount	Total	Date	Material	Amount
7-1-57	labor	2 04		7-1-57	Deposit	\$ 10 00
	10% overhead	20		10-28-57	Refund	7 95
			2 24			\$ 2 05
	Owner's copper				No Charge	
	1 3/4" C x 1/2 IWH st. & waste		4 96	11-30-51	Labor	2 58
	1 hr. trucking @ .75		75		25' - 3/4" Copper Tubing @ .326	8 15
			7 95		1-3/4" C Corp Cock	4 33
					1-3/4" C x 3/4" C Curb Cock	4 67
					1- Box & Rod	4 68
					1 Hr. Trucking	75
					Total	25 16
					Trench Dug By Owner	
					1 1/8 straight tailpc.	50
						50
						26 06

DATE _____

TOWN OF LEXINGTON — BOARD OF PUBLIC WORKS
WATER DIVISION

Sketch of Service Here

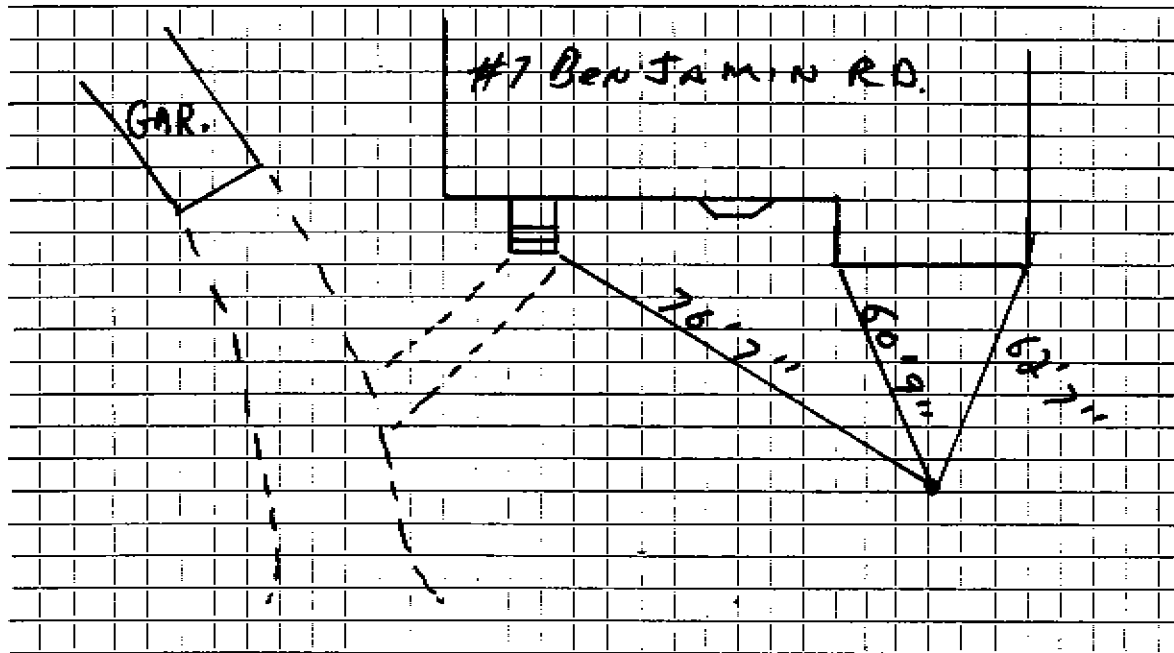

Connection made in Street. Work completed

Remarks:

.....
.....