

1444
6777

WATER SERVICE RECORD

Name Simeone Demone

Service No. 43

Address 8 Benjamin Road

Location

Repair ~~Remove~~ New Service

Com. 5-3-54


Date	Material	Amount	Total	Date	Amount
3/17/51	Labor	9 80		3-11-54	
	10 % overhead	98	10 78	3-3-54	
	60' 3/4" Copper tubing @ .35		21 00	Deposit	65 00
	1-3/4" C 1/2 L.W.H. Stop & Waste		1 00	NON CHARGE	11 25
	1 -3/4" C x 3/4" C. union		1 72		53 25
	2 hr Littlefield shovel @ 7.50	15 00		Service was in to curb	
	1 hr trucking		75	1-1/8 offset tail piece	50
			53 25	1- Straight tail piece	50
					1 00
				NON CHARGE	
				11730/51 Labor	2 58
				10' 3/4" copper tubing @ .326	3 26
				1 3/4" C corp cock	4 33
				1 3/4" C x 3/4" C Curb cock	4 67
				1 Box and Rod	4 68
				1 Hr. trucking	75
					20 27
				trench dug by owner	

DATE _____

TOWN OF LEXINGTON — BOARD OF PUBLIC WORKS

WATER DIVISION

Sketch of Service Here

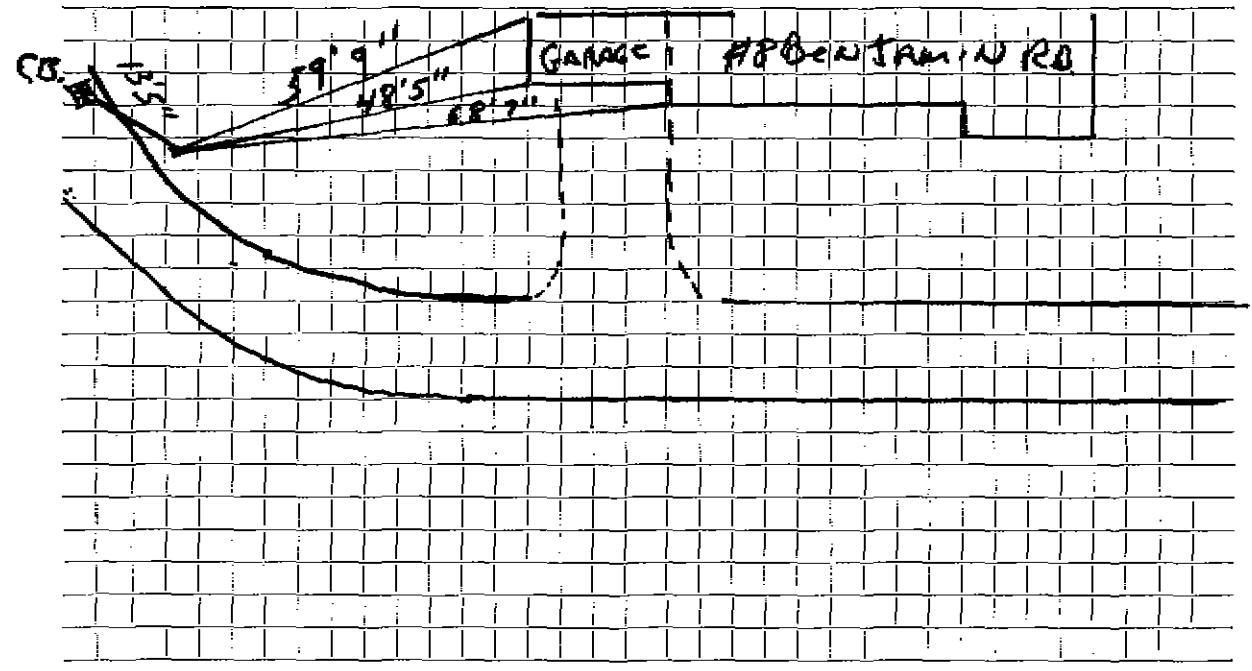

Connection made in _____ Street. Work completed _____

Remarks: _____

