

11-3-52

WATER SERVICE RECORD

Name P. Madonna

Service No. 160

Address 9 Benjamin Road

Location Lexington

Com. 11-3-52

Repeat ~~Work~~ - New Service

SERVICE WAS IN TO CURB


Date	Material	Amount	Total	Date	Amount
10/1/52	Labor	1 63		<i>F-4-32</i>	<i>Deposited</i>
	10% Overhead	16	1 79	<i>11-5-52</i>	<i>Refunded</i>
	1 - 3/4" C x 1/2 I.W.H. stop & waste	4 00			<u>NON CHARGE</u>
	1 hr. trucking		75	10/1/52	Labor
			6 54		1 - 1/2 offset tail piece
					1 - 1/2 straight tail piece
					2 63
	PIPE SUPPLIED & LAID BY OWNER				
	TRENCH DUG BY OWNER				
				3/21/52	<u>NON CHARGE</u>
					Labor
				23'	3/4" copper tubing @ .3439
				1	3/4" C corp cock
				1	3/4" C x 3/4" C. curb cock
				1	Box and rod
				1	hr. trucking
					75
					XXXXXX
					25 59

DATE _____

TOWN OF LEXINGTON — BOARD OF PUBLIC WORKS

WATER DIVISION

Sketch of Service Here

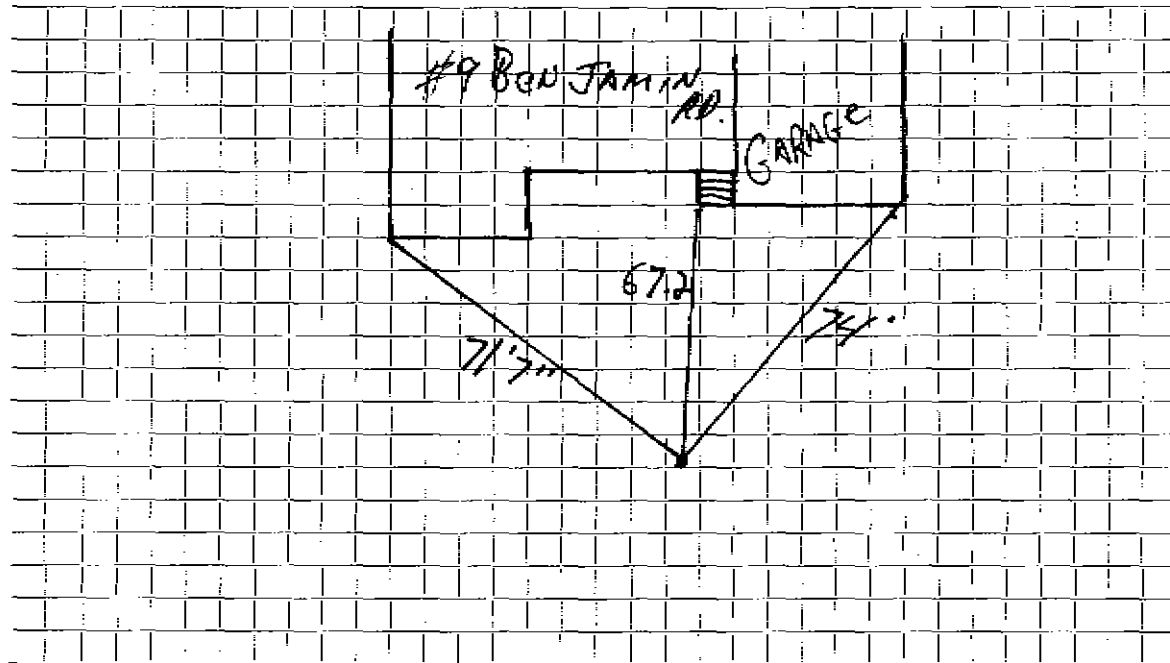

Connection made in Street. Work completed

Remarks:

.....

.....