

WATER SERVICE RECORD

Name

Service No.

Address

15 BENNETT AVE

Location

Repair—Renewal—New Service


RENEWAL

Date	Material	Amount	Total	Date	Amount
10 94	20.5' OF 1" COPPER 1-1" CURB STOP 1-1" x 3/4" REDUCER				
				OUTSIDE	
				3/26/53 25'	3/4" Copper tubing
				1	3/4" C Corp Cock
				1	3/4" C x 3/4" Curb Cock
				1	Box & Rod

DATE 10/94

TOWN OF LEXINGTON — BOARD OF PUBLIC WORKS
WATER DIVISION

Sketch of Service Here

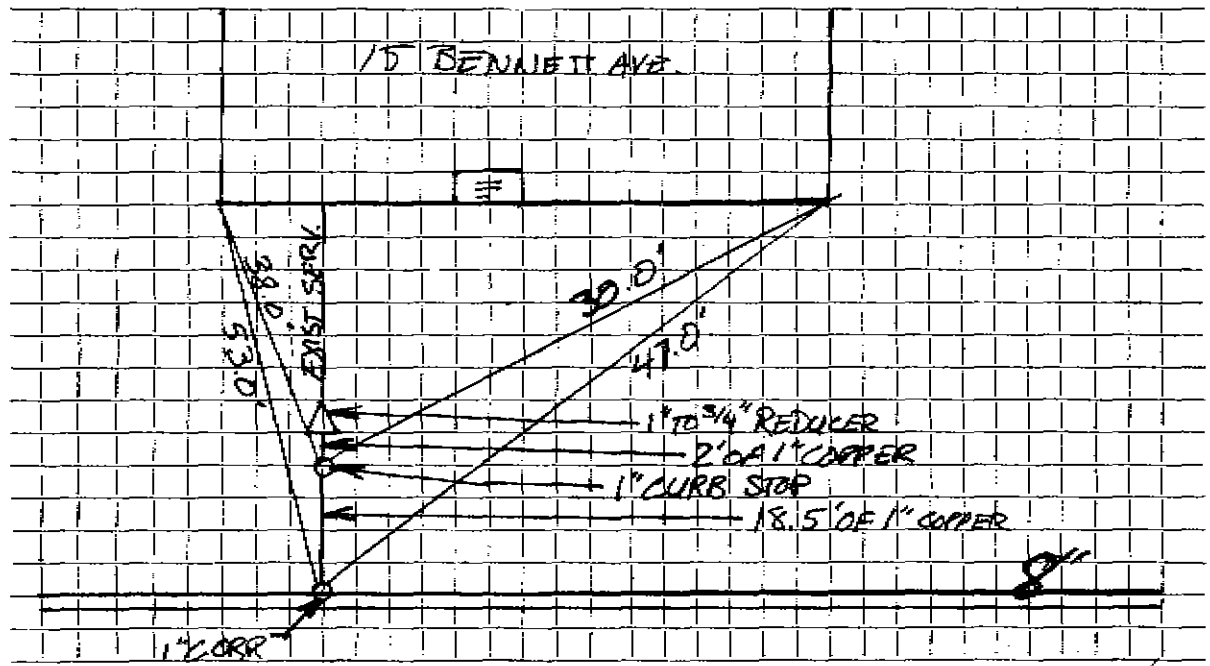

Connection made in Street.

Work completed ... 3.1.94. 521 M.C. 9-13-27

Remarks:
.....
.....