

WATER SERVICE RECORD

#3016

Name Ralph Frissore

Service No. 69

Address 6 Bennett Avenue

Location \_\_\_\_\_

Repair—Renewal—New Service

Comm 9-24-54

Date	Material	Amount	Total	Date	Amount
4/10/56	Labor	1 90		4-9-56 Deposit	50 00
	10% overhead	19	2 09	9-24-56 Refund	16 50
	53' 3/4" Copper tubing @ .4850		25 70	Labor	33 50
	1 3/4" C x 1/2" I.W.H. stop&waste		4 96	NON CHARGES	1 90
	1 hr. trucking @ .75		75	18' 3/4" copper tubing @ .4850	8 73
			33 50	1 3/4" C. Corp Cock	4 34
				1 3/4" C. Curb Cock	5 94
				1 Box & Rod	1 62
				1 3/8 Straight tail piece	50
				1 1/2 Offset tail piece	50
					26 53


\* # 1388 applied to S.H.C #26

DATE \_\_\_\_\_

TOWN OF LEXINGTON — BOARD OF PUBLIC WORKS

WATER DIVISION

Sketch of Service Here

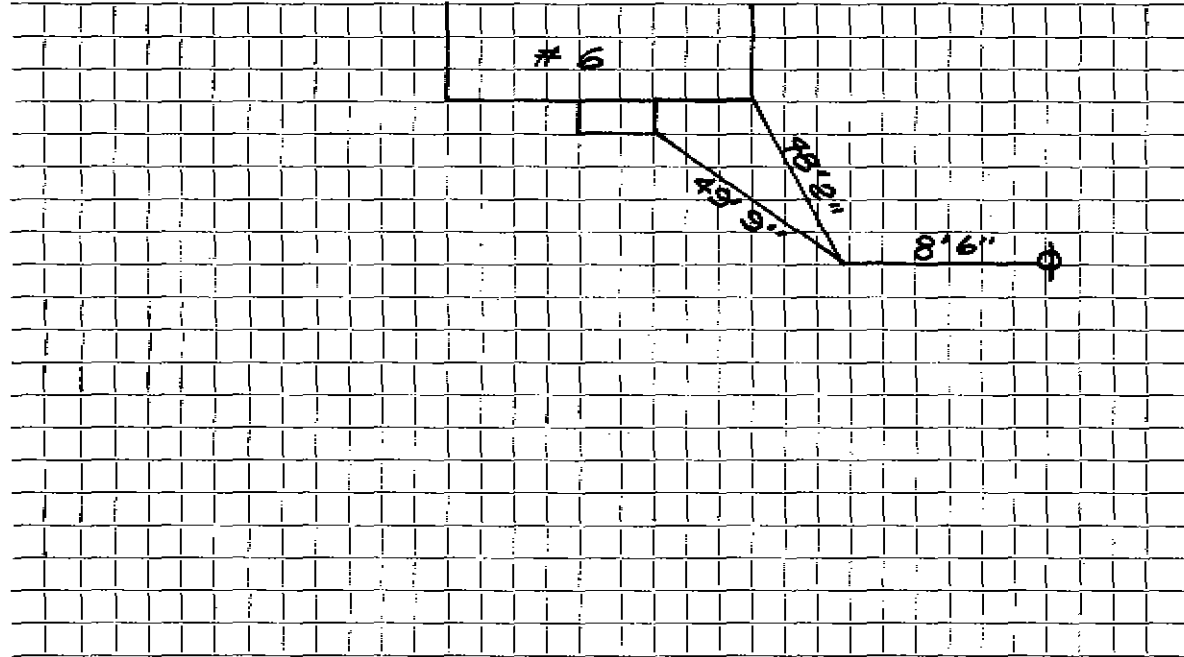

Connection made in ..... Street.      Work completed .....

Remarks: .....  
.....  
.....