

Name George Sheldon

Service No. 183

Address 1 Bennington Road

Location 1 Bennington Road

Kind of Pipe

Size

Size of Main

~~Repair~~—Renewal—~~New Service~~

Com. 12/3/47

Location

Date	Material	Amount	Total	Date	Amount
12/10/47	Labor	24 30	24 30	12/10/47	75 00
	10% Overhead		2 43	Mar. 1, 48	4 81
	77' 1" Copper Tubing @ .32		24 64		79 81
	1 1" CX 3/4" I.W.H. S & W		3 15		
	2 1" Cx 1" C. Union (3 pts.)		3 54	Non-Charge	
	3 hrs. Hired Shovel @ 7.00		21 00	12/10/47 Labor	45 80
	1 hr. Trucking		75	21' 1" Copper Tubing @ 32	6 72
			79 81	1 1" Copper Adapter	1 60
				1 1" Cx 1" C Curb-cock	4 80
6/28/78	Labor work order # 2464			4 hrs. Compressor @ 2.75	11 00
	1" corporation'			1 hr. Trucking	75
	5' 1" copper			Patching 15x3	15 00
	1" Three part union				85 67
	1 hr. trucking				
	Labor				

George Sheldon

DATE _____

TOWN OF LEXINGTON - BOARD OF PUBLIC WORKS

WATER DIVISION

The undersigned applies for a supply of water at No..... St. and hereby agrees to comply with the rules and regulations as now, or at any future time, established by the Board of Selectmen.

Am't of Estimate \$.....

Owner


Am't Paid \$.....

Address

Builder

.....

Sketch of Service Here

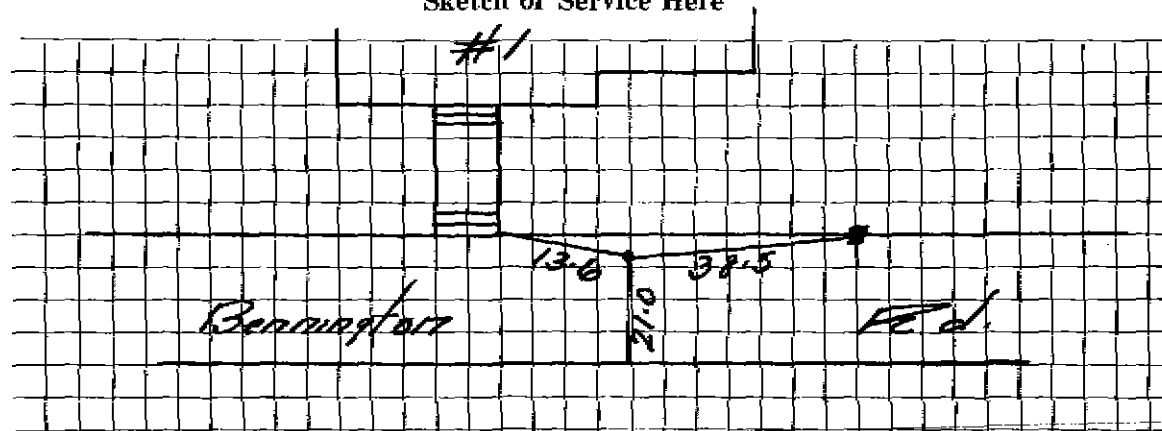

Connection made in Street.

Work completed19

Remarks: