




DATE \_\_\_\_\_

TOWN OF LEXINGTON — BOARD OF PUBLIC WORKS

WATER DIVISION

Sketch of Service Here

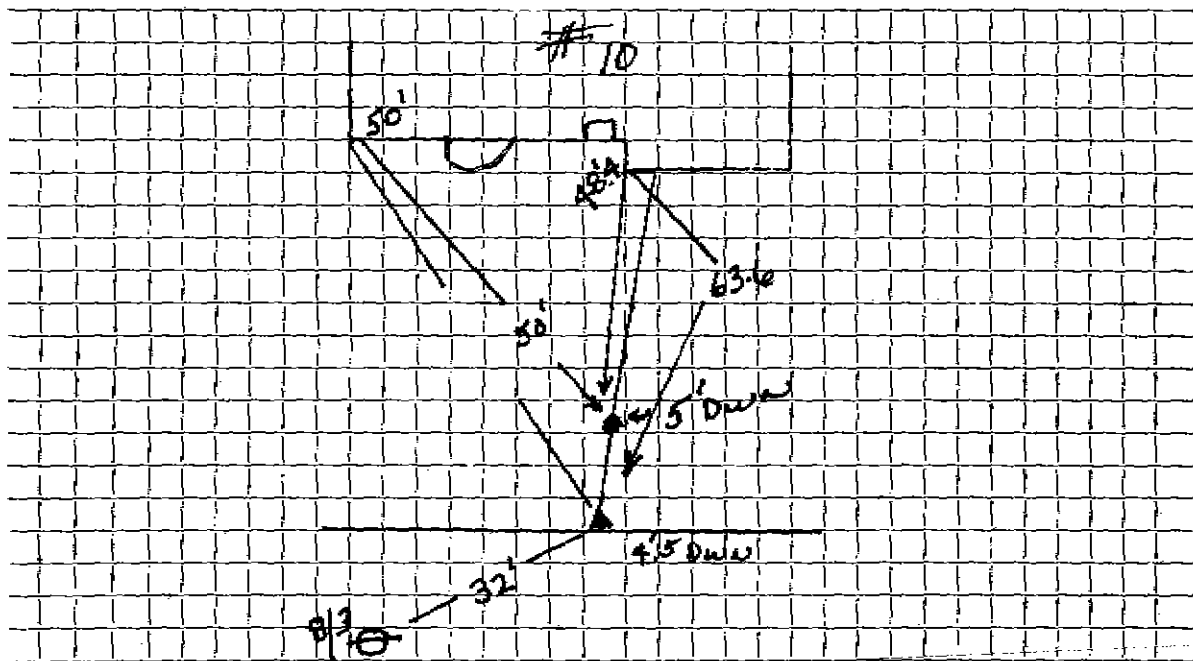

Connection made in ..... Street. Work completed .....

Remarks: GOES OVER LEDGE between CORP & CURB 4' DWV INSULATION

AT House Ledge with INSULATION OWNER WAS TOLD They would be RESPONSIBLE FOR

FREEZING: 7/7/94