

WATER SERVICE RECORD

AUG 21 1978

Name Raymond J. Ciccolo

Service No. 18

Address 11A Bennington Road

Location (Garage)

~~Repair/RENEWAL~~ New Service W.O. #6503


Date	Material	Amount	Total	Date	Amount
8-7-78	Labor	19.42		7-11-78	150.00
	10% O.H.	1.94	21.36	8-21-78	43.75
25'	3/4" Copper tubing @.74		18.50		81.25
1	3/4" Corp.		11.27		
1	3/4" Curb		16.12		
1	box & Rod		11.00		
1	hr. Trucking		3.00		
			81.25		
10/31/78	39' 1" Copper				

DATE _____

TOWN OF LEXINGTON — BOARD OF PUBLIC WORKS

WATER DIVISION

Sketch of Service Here

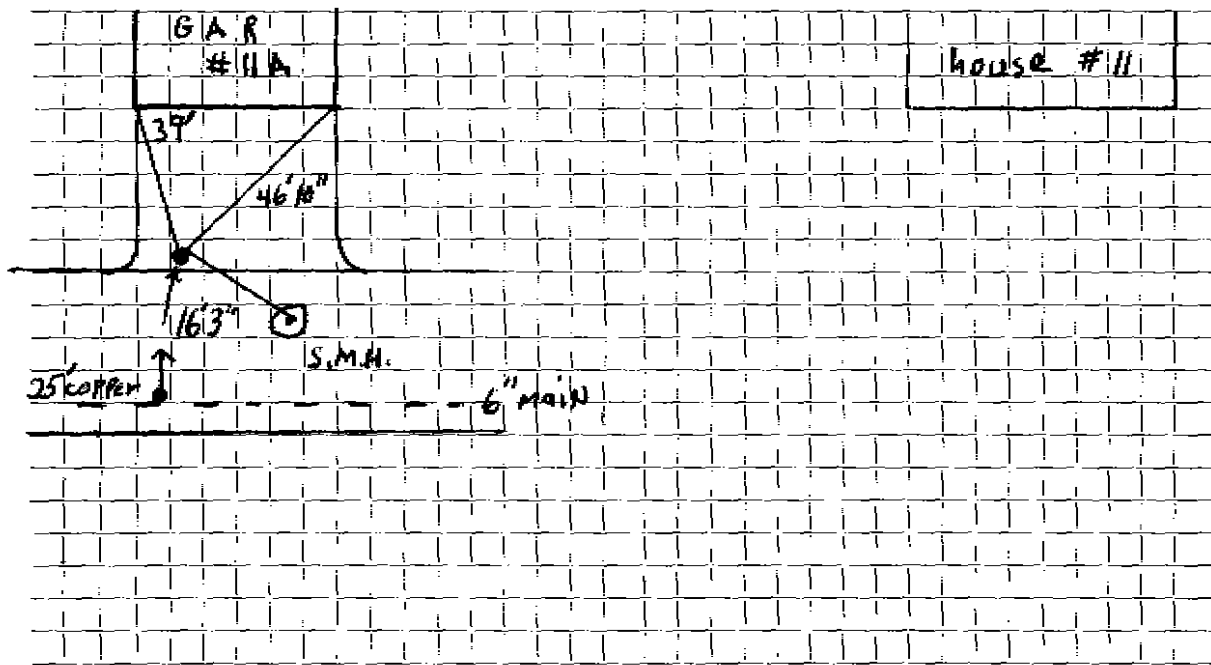

Connection made in _____ Street. Work completed _____

Remarks: _____
