

Name Albert O. Wilson

Service No. 268

Address 24 Bennington Road

4930

Lexington, Mass.

Location 24 Bennington Road

Kind of Pipe

Size

Size of Main

~~Repair~~ ~~Work~~ New Service

Com. 11-6-50

Location

Date	Material	Amount	Total	Date	Amount	
Aug. 24, '50	Labor	35 05	35 05	Aug 28 '50	100 00	
	10% Overhead		3 51	Dec 4 '50	9 80	
	165' - 1" Copper Tubing @.284		46 86		189 80	
	1 - 1"C x 1" I.W.H. S&W		4 48	8-24-50	Labor	17 05
	2 - 1"C x 1"C Unions (3pts)		3 66	20' - 1" Copper Tubing @.284		5 68
	1 - 1"x 3/4" Bushings		49	1 - 1" C Corp-cock		4 62
	Dynamite 22 lbs. @.215		4 73	1 - 1"C x 1"C Curb-cock		5 60
	Caps 12 @ .293		3 52	1 - Box & Rod		3 35
	Compressor #36 4 hrs.@ 2.75		11 00	1 - 3/4" Offset Tail Piece		42
	Brox Shovel 5 hrs.@ 9.00		45 00	1 - 3/4" Straight Tail Piece		42
	Trucking 2 hrs. @.75		1 50	Dynamite 8 lbs. @.215		1 72
			159 80	Caps 9 @ .293		2 64
	Labor			Compressor 2 hrs. @ 2.75		5 50
				Brox Shovel 4 2/3 hrs.@9.00		42 00
				Trucking 2 hrs. @.75		1 50
						90 50

*Reported
Card
No Charge*

Hadley Press, Inc., Lexington

DATE _____

TOWN OF LEXINGTON—BOARD OF PUBLIC WORKS

WATER DIVISION

The undersigned applies for a supply of water at No. _____ St. and hereby agrees to comply with the rules and regulations as now, or at any future time, established by the Board of Selectmen.

Am't. of Estimate \$ _____


Owner _____

Am't. Paid \$ _____

Address _____

Builder _____

Sketch of Service Here

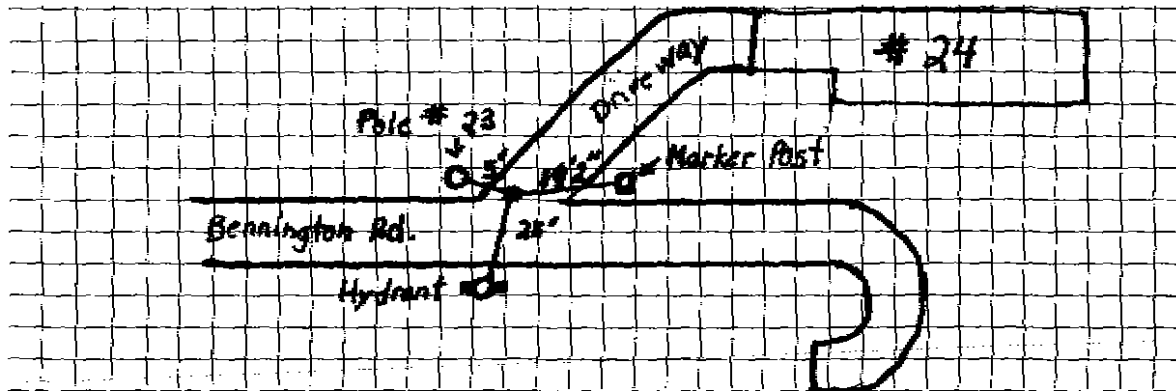

Connection made in _____ Street. Work completed _____ 19

Remarks: