


DATE _____

TOWN OF LEXINGTON — BOARD OF PUBLIC WORKS
WATER DIVISION

Sketch of Service Here
4 BENNINGTON

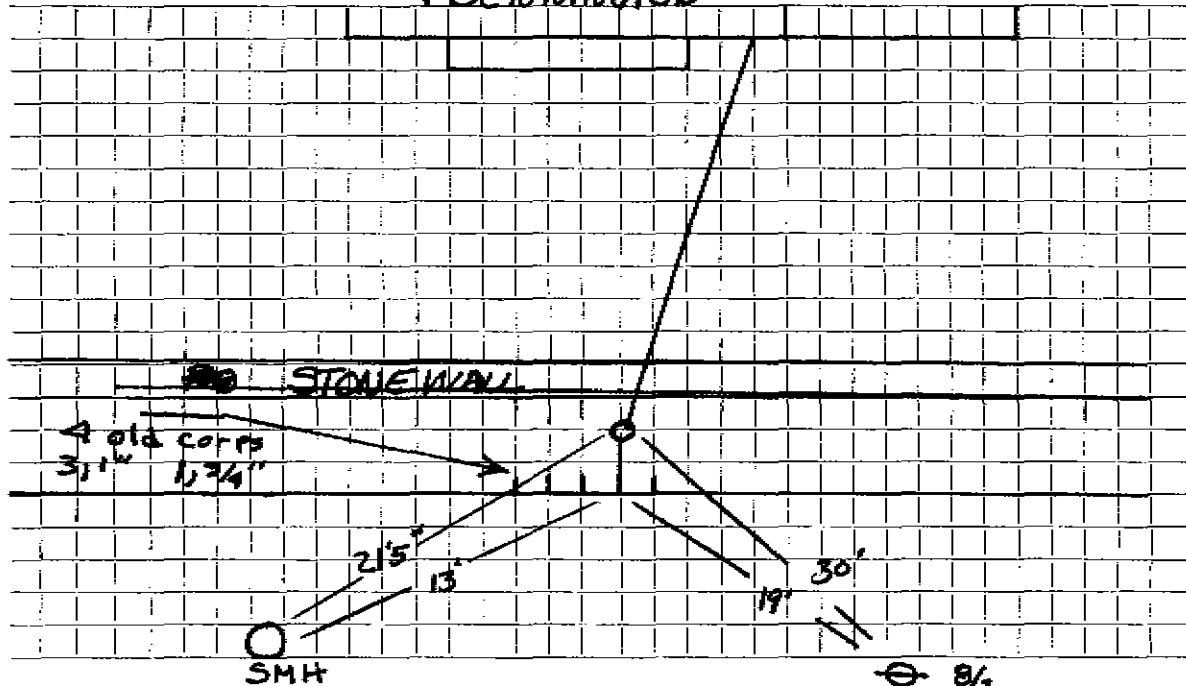

Connection made in Street. Work completed $\text{Ø } 8/2$

Remarks:
.....
.....