




DATE 10/8/19

TOWN OF LEXINGTON — BOARD OF PUBLIC WORKS

WATER DIVISION

Sketch of Service Here

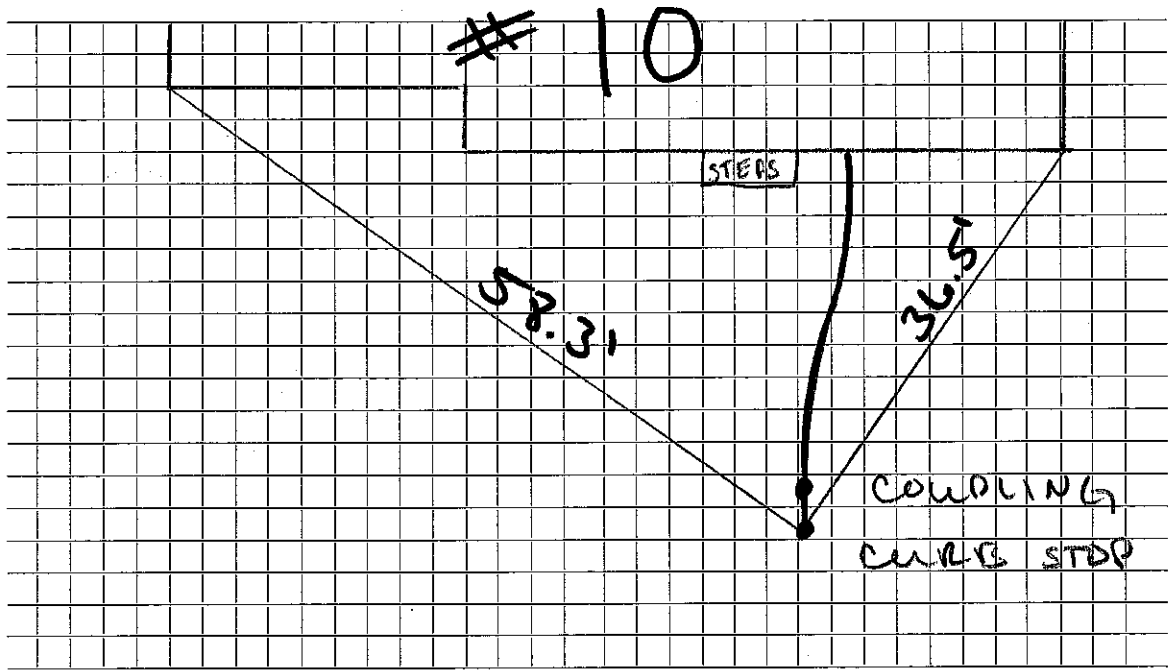

Connection made in Bernard Street. Work completed .....

Remarks: Steel line existing