

Name Regina L. Barrow

Service No. ~~122~~ 246

Address 87 Union St., Everett  
20 Bernard Street

\$ 2540

Location Lot #332, Bernard Street #20

Kind of Pipe

Size

Size of Main

Repair—Renewal—New Service

Location

Date

Material

Amount

Total

Date

Amount

37 1" C.L. Pipe @.27

9 99

2 1" L.L. Coup. @.30

60

1 1" L.L. Ell

35

1 1" Br. Sp. Nipple

25

1 S & W

3 00

Trucking

75

14 94

P. 10-23-28 for  
15.00 ✓  
P. 11-27-28 for  
5.75 ✓

Oct. 19 1928 - Cash 15.00  
Nov. 1 1929 - Cash 5.75

11/1/28 7 Hours Labor @ .55

3 85

2 " " @ .60

1 20

5 05

15% Overhead

76

20 75

27.05 Outside copper

Labor

27.05 REPAIR MADE INSIDE  
web - 5' 1" Copper  
3/4 x 1 3 pt union  
1 x 1 iron to copper adpt - Buffalo Box

Hadley Press, Inc. Lexington

DATE October 15, 28

TOWN OF LEXINGTON—BOARD OF PUBLIC WORKS

**WATER DIVISION**

The undersigned applies for a supply of water at No. <sup>Lot</sup> 332, Bernard St. St. and hereby agrees to comply with the rules and regulations as now, or at any future time, established by the Board of Selectmen.

Am't. of Estimate \$ \_\_\_\_\_

Owner Reginald L. Barrow


Am't. Paid \$ \_\_\_\_\_

Address 87 Union St.

Builder \_\_\_\_\_

Eventt.

Sketch of Service Here

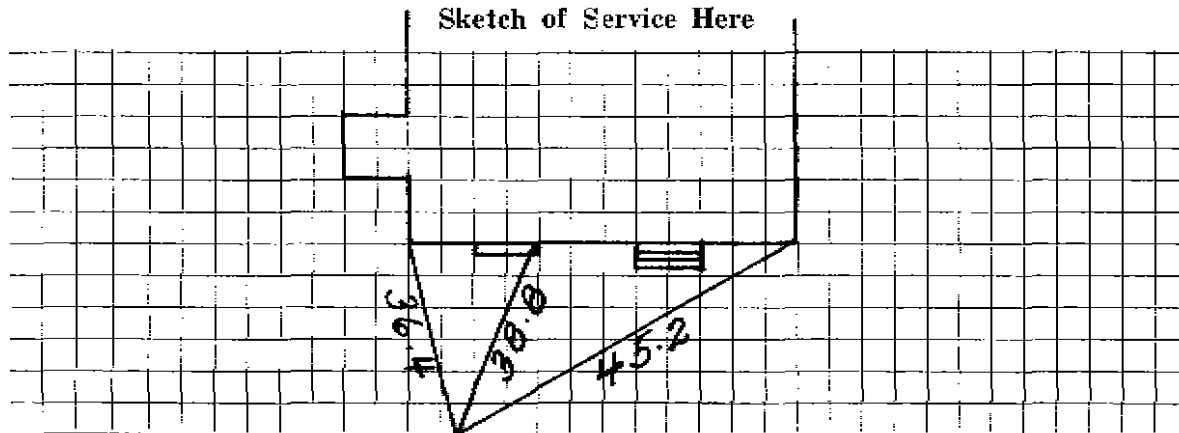

Connection made in \_\_\_\_\_ Street. Work completed \_\_\_\_\_ 19

Remarks: