

WATER SERVICE RECORD

Name John Muerer

Service No. 85

Address 21 Bernard St.

2497

Location Lexington

~~Repair/Repair~~ - New Service


Com. 7-13-53

Date	Material	Amount	Total	Date	Amount
6/11/53	Labor	1 75		5-1-53	Deposit of 25 00
	10% overhead	18	1 93	7-13-53	Refunded (3 52)
	40' 3/4" Copper Tubing @.37		14 80		NON CHARGE 21 48
	1-3/4" C x 1/2 I.W.H. STOP & WASTE		4 00	6/11/53	Labor 1 75
	1 Hr. Trucking		75	28' 3/4" Copper Tubing @.37	10 36
			21 48	1-3/4" C. Corp-cock	4 33
				1-3/4" C x 3/4" C. Curb-cock	4 67
				1-Box & Rod	3 90
				1-1/2" offset tail piece	50
				1-1/2" straight tail piece	50
				1 Hr. Trucking	75
					26 76

DATE _____

TOWN OF LEXINGTON — BOARD OF PUBLIC WORKS
WATER DIVISION

Sketch of Service Here

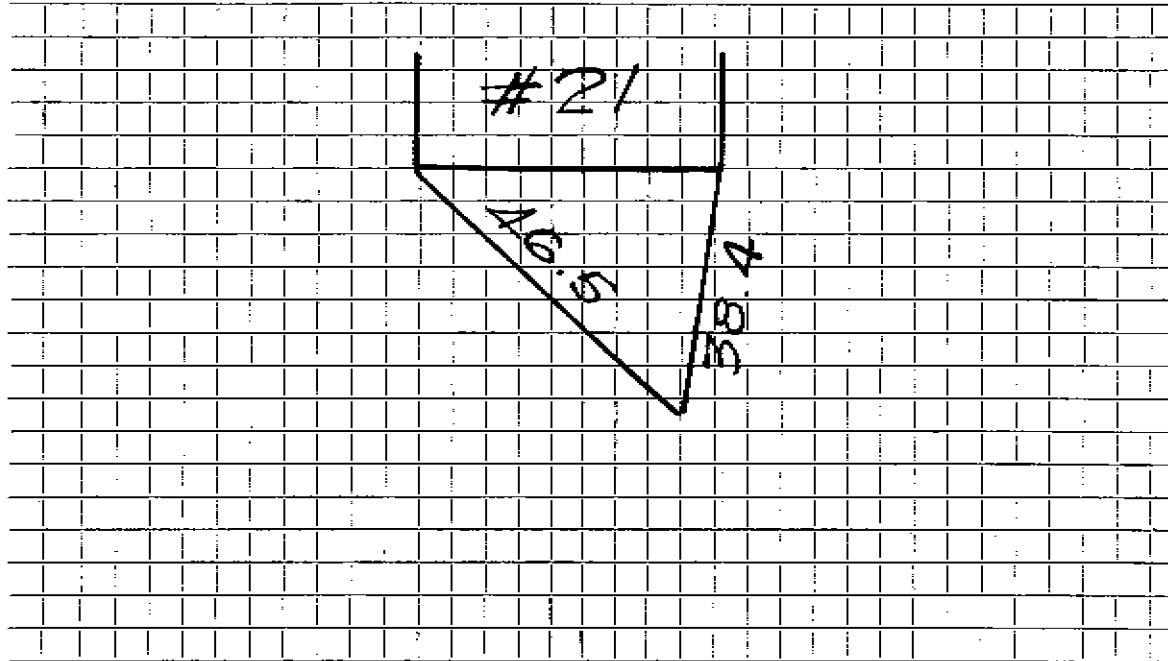

Connection made in Street. Work completed

Remarks:

.....

.....