

Name Barry Parker Realty

Service No.

Address 25 Bernard Street

167
#5071
#5072
#7706

Lexington, Mass.

Location 25 Bernard Street

Kind of Pipe

Size

Size of Main

~~Repair-Renewal~~—New Service

Location

Date	Material	Amount	Total	Date	Amount
Aug. 31, '48	Labor	13 71	13 71	Aug. 24 '48	35 00
	10% Overhead		1 37	Oct. 20 '48	8 71
	31'-3/4" Copper Tubing		7 91		26 89
	1-3/4" C x 1/2" I.W.H. S & W		3 15	Aug. 31, '48	15 15
	1 hr. Trucking		75	30'-3/4" Copper Tubing	7 65
			26 89	1-3/4" C. Corp. Cock	3 00
				1-3/4" C x 3/4" C. Curb Cock	3 68
				1-Box & Rod	3 55
				1 hr. Littlefield Shovel	7 00
				1-1/2" Straight Tail Piece	30
				1-1/2" Offset Tail Piece	30
				1 hr. Trucking	75
					41 38

Com 10/25/48

Labor

Deposited
Refunded
Non Charge

Hadley Press, Inc., Lexington

TOWN OF LEXINGTON—BOARD OF PUBLIC WORKS

WATER DIVISION

The undersigned applies for a supply of water at No. _____ St. and hereby agrees to comply with the rules and regulations as now, or at any future time, established by the Board of Selectmen.

Am't. of Estimate \$ _____


Owner _____

Am't. Paid \$ _____

Address _____

Builder _____

Sketch of Service Here

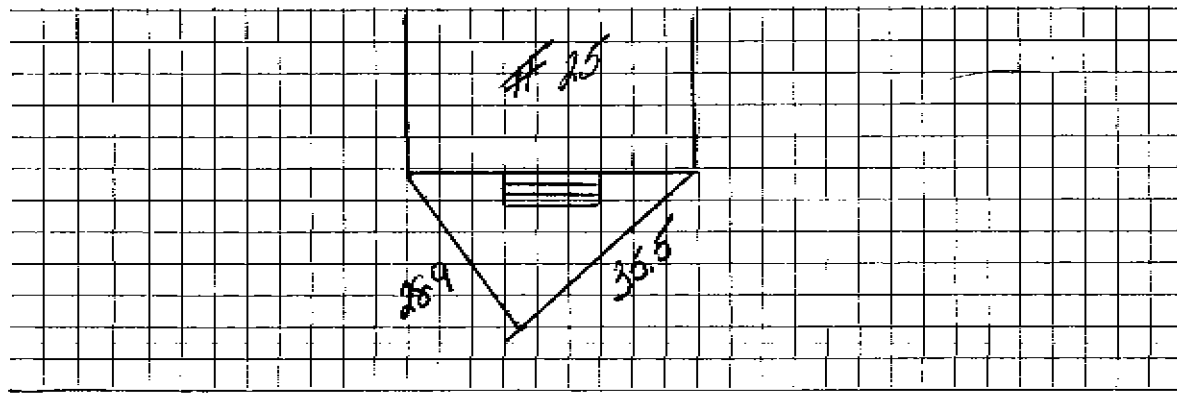

Connection made in _____ Street.

Work completed _____ 19

Remarks: