

Name Arthur Mitchell
 Address 26 Bernard Street
 Lexington, Mass.

Service No. 256
 # 5929

Locatio 26 Bernard Street

Kind of Pipe Size Size of Main

~~Repair - Renewal~~ - New Service Com. 11-6-50 Location

Date	Material	Amount	Total	Date	Location	Amount
Aug. 28, '50	Labor	2 55	2 55	Aug 21 '50	Deposited	35 00
	10% Overhead		26			34
	10' - 3/4" Copper Tubing @.275	11 00			No Charge	3, 85
	1 - 3/4" x 1/2" I.W.H. SSW	3 29		Aug. 28, '50	Labor	3 18
	Littlefield Shovel 2 hrs. @7.00	14 00			10' - 3/4" Copper Tubing @.275	2 75
	Trucking 1 hr. @.75	75			1 - 3/4" Corp-cock	3 15
			31 85		1 - 3/4" x 3/4" Curb-cock	3 85
					1 - Box & Rod	3 35
					1 - 1/2" Straight Tail Piece	42
					1 - 1/2" Offset Tail Piece	42
					Littlefield shovel 1 hr. @.7.00	7 00
					Trucking 1 hr. @.75	75
	Labor					24 87

Bradley Press, Inc., Lexington

DATE _____

TOWN OF LEXINGTON—BOARD OF PUBLIC WORKS

WATER DIVISION

The undersigned applies for a supply of water at No. _____ St. and hereby agrees to comply with the rules and regulations as now, or at any future time, established by the Board of Selectmen.

Am't. of Estimate \$ _____


Owner _____

Am't. Paid \$ _____

Address _____

Builder _____

Sketch of Service Here

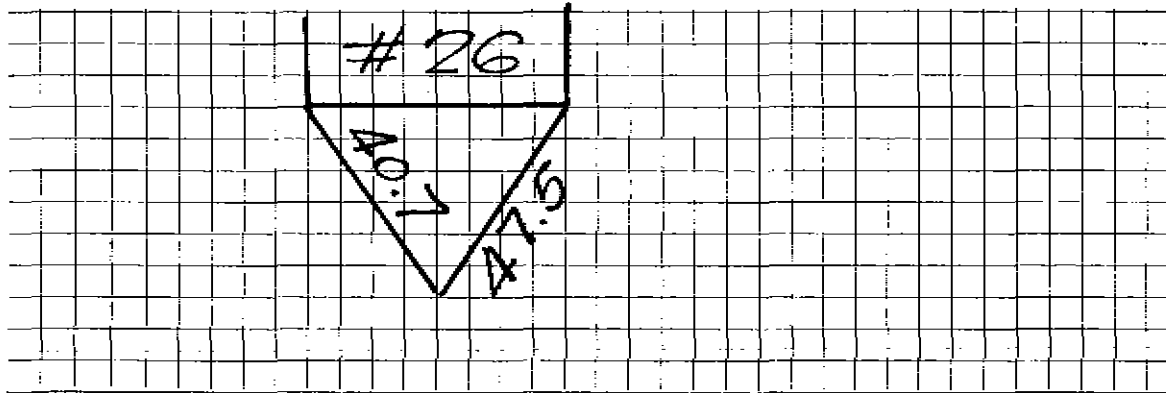

Connection made in _____ Street.

Work completed _____ 19

Remarks: