

WATER SERVICE RECORD

#2477

Name Ralph F. Clarke

Service No. 140

Address 27 Bernard Street

Location

Repairs ~~Reconnect~~ - New Service

Comm. 10-8-56


Date	Material	Amount	Total	Date	Amount	
6/22/56	Labor	1 90		6-8-56	Deposit	50 00
	10% overhead	20	2 10	10-8-56		24 24
	37' - 3/4" Copper tubing @ .4850	17 95			NON CHARGE	25 76
	1 3/4 Cx 1/2 I.W.H. Stop & Waste	4 96		6/22/56	Labor	1 90
	1 hr. trucking		75	24'	3/4" Copper tubing @ .4850	11 64
			25 76		1 3/4" C. Corp Cok	4 64
					1-3/4" C. Curb Cok	5 94
					1 Box & Rod	4 62
					1 - 1/2 Straight tailpiece	50
					1 - 1/2 Offset tailpiece	50
						29 74

DATE _____

TOWN OF LEXINGTON — BOARD OF PUBLIC WORKS

WATER DIVISION

Sketch of Service Here

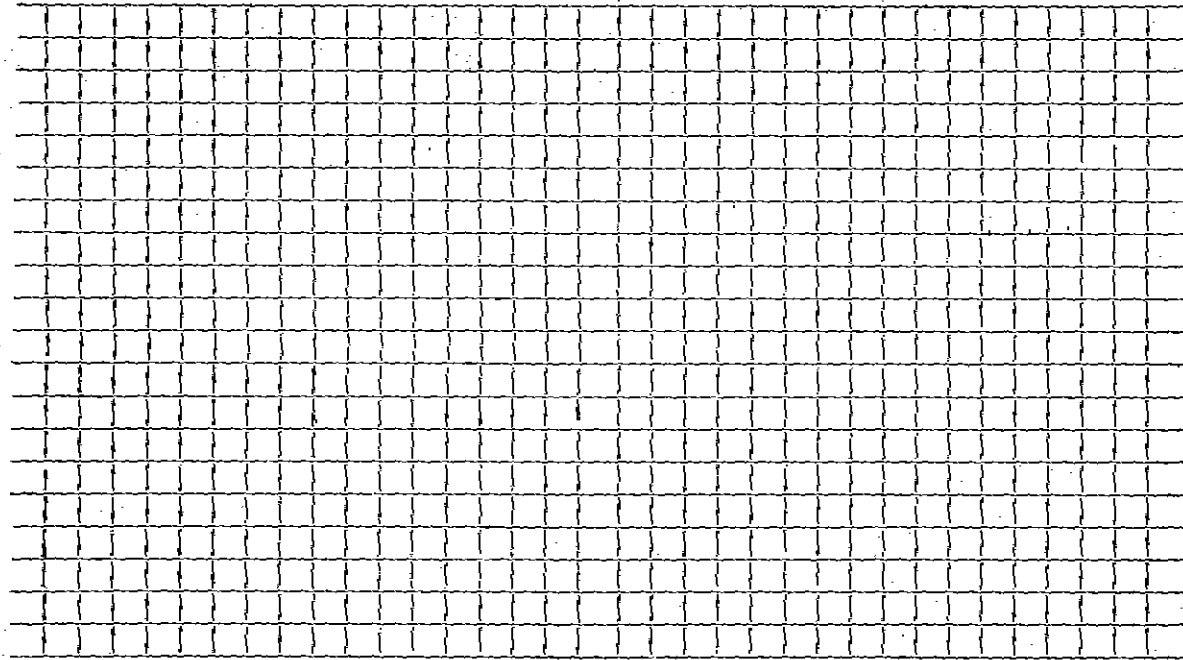

Connection made in Street. Work completed

Remarks:

.....

.....