

WATER SERVICE RECORD

#605  
#606

Name William E. Roy

Service No. 167

Address 28 Bernard Street

f 6884

Location

~~Repair~~ - New Service

*Com. 8-10-53*


Date	Material	Amount	Total	Date	Amount
7/8/53	Labor	1 75		6-20-53	Deposited 25 00
	10% overhead	18	1 93	8-10-53	Refunded 2 35
	44' - 3/4" copper tubing@.3629	15 97			<u>NON CHARGE</u> 22 65
	1 -3/4" c x 1/2 I.W.H. stop & waste	4 00	4 00	7/8/53	Labor 1 75
	1 hr. trucking		75	13' - 3/4" copper tubing@.3629	4 72
			22 65	1 - 3/4" C. corp-cock	4 33
				1 - 3/4" C x 3/4" C. curb-cock	4 67
				1 box and rod	3 90
				1 - 1/2 straight tail pc.	50
				1 - 1/2 offset tail pc.	50
				1 box and rod	3 90
					24 27

DATE \_\_\_\_\_

TOWN OF LEXINGTON — BOARD OF PUBLIC WORKS

**WATER DIVISION**

Sketch of Service Here

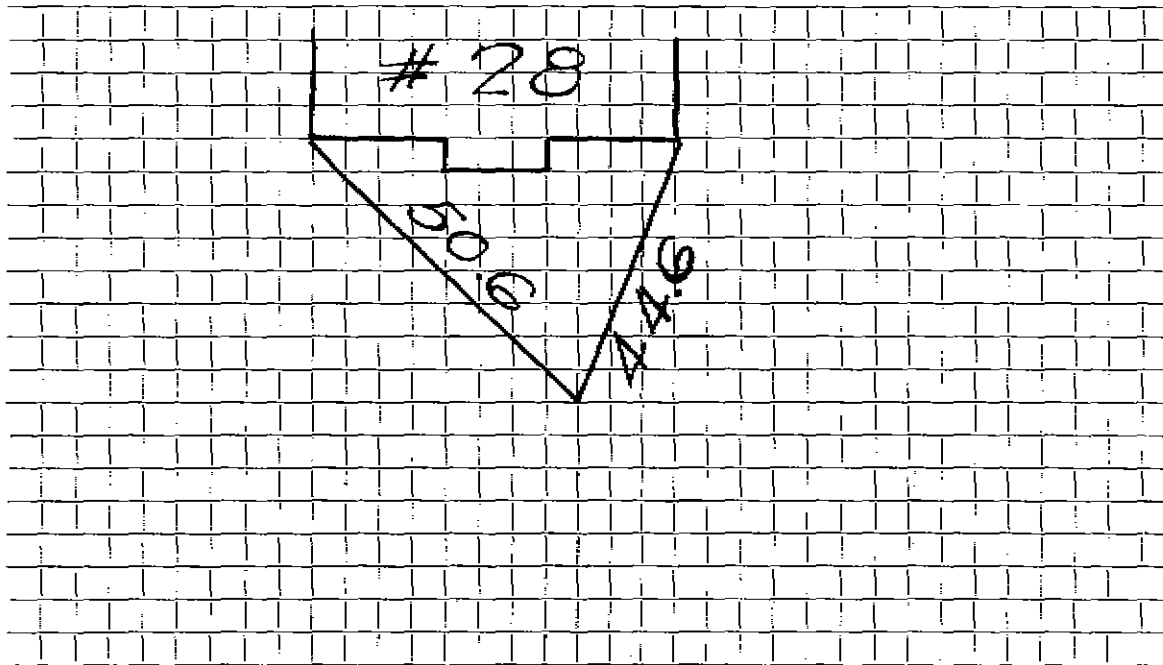

Connection made in \_\_\_\_\_ Street. Work completed \_\_\_\_\_

Remarks: \_\_\_\_\_

\_\_\_\_\_  
\_\_\_\_\_