

Name Harry Parker Realty

Service No. 100

Address 29 Bernard Street

509

Lexington, Mass.

Location 29 Bernard Street

Kind of Pipe

Size

Size of Main

Repair—Renewal—New Service

Location

Date	Material	Amount	Total	Date	Amount
Aug. 27, '48	Labor	6 10	6 10	Aug 24 48	Deposited 25 00
	10' Overhead		61	Oct 28 48	Refunded 9 00
	31' - 3/4" Copper tubing 2.25	7 91			Non-Charge 25 52
	1 - 3/4" C x 1/2" T.W.A. 3 & 3	3 15		Aug. 27, '48	Labor 6 77
	Littlefield Shovel 1 hr. 27.00	7 00			30' - 3/4" Copper tubing 2.25
	Trucking 1 hr. 2.75	75			1 - 3/4" C carb-cock 3 00
		25 52			1 - 3/4" C x 3/4" C carb-cock 3 68
					1 - box wood 3 55
					Littlefield Shovel 1 hr. 27.00 7 00
					1 - 3" straight Tail Piece 30
					1 - 3" offset Tail Piece 30
					Trucking 1 hr. 2.75 75
	Labor				33 00

Com. 10/25/48

Findley Press, Inc., Lexington

DATE _____

TOWN OF LEXINGTON—BOARD OF PUBLIC WORKS

WATER DIVISION

The undersigned applies for a supply of water at No. _____ St. and hereby agrees to comply with the rules and regulations as now, or at any future time, established by the Board of Selectmen.

Am't. of Estimate \$ _____


Owner _____

Am't. Paid \$ _____

Address _____

Builder _____

Sketch of Service Here

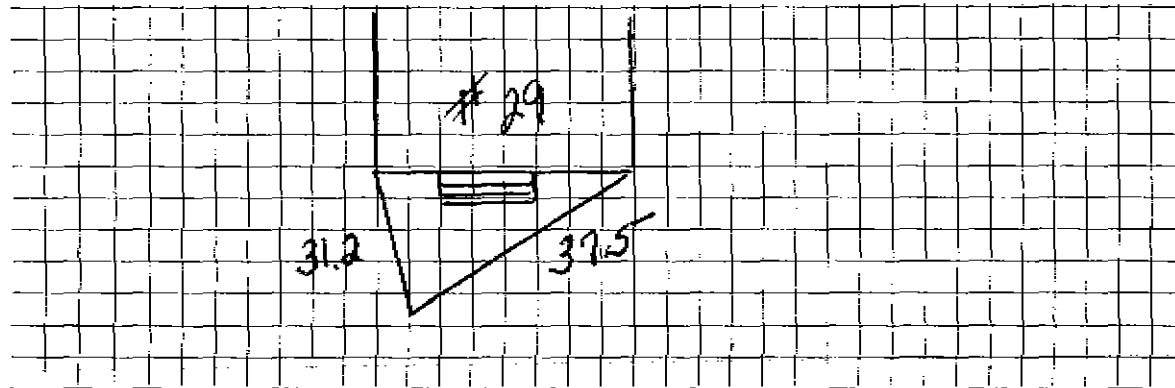

Connection made in _____

Street.

Work completed _____ 19

Remarks: