

Name Enrico Spagnuolo
 Address 33 Bernard Street
 Lexington, Mass.

Service No. 11

Location 33 Bernard Street

Kind of Pipe Size Size of Main
 Repair—Renewal—New Service Com. 8-23-48 Location

Date	Material	Amount	Total	Date	Amount	
June 16, '48	Labor	4 00	4 00	June 3 '48	<i>Deposited Paid Non-Charge</i>	25 00
	10% Overhead		40	Sept 15 '48		8 91
	L2' - 3/4" Copper Tubing @ .255	10 71				<u>33 01</u>
	1 - 3/4" C x 1/2" I.W.S. S & W	3 15		June 16, '48	Labor	5 85
	Littlefield Shovel 2 hrs. @ 7.00	14 00		31' - 3/4" Copper Tubing @ .255		7 91
	Trucking 1 hr. @ .75	75		1 - 3/4" C Corp-cock		3 00
			33 01	1 - 3/4" C x 3/4" C Curb-cock		3 68
				1 - Box & Rod		3 55
				1 - 1/2" Straight Tail Piece		30
				1 - 1/2" Offset Tail Piece		30
	Part of trench dug by owner			Littlefield Shovel 2 hrs. @ 7.00		14 00
				Loader 2 hrs. @ 3.00		6 00
	Labor			Trucking 1 hr. @ .75		75
						<u>45 34</u>

Hadley Press, Inc., Lexington

DATE _____

TOWN OF LEXINGTON—BOARD OF PUBLIC WORKS

WATER DIVISION

The undersigned applies for a supply of water at No. _____ St. and hereby agrees to comply with the rules and regulations as now, or at any future time, established by the Board of Selectmen.

Am't. of Estimate \$ _____


Owner _____

Am't. Paid \$ _____

Address _____

Builder _____

Sketch of Service Here

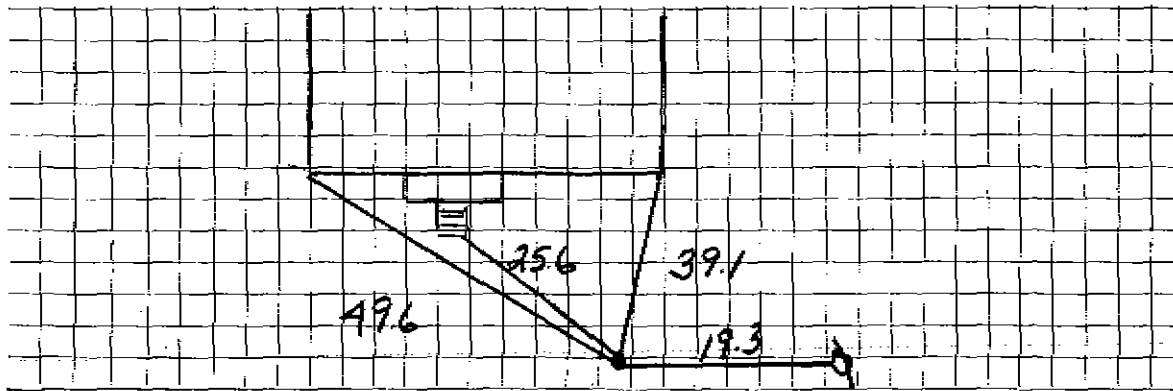

Connection made in _____ Street.

Work completed _____ 19

Remarks: