

WATER SERVICE RECORD

Name Eric G. Sahlberg

Service No. 368 (1956)

Address 37 Bernard Street

Location

~~Repair~~ ~~Material~~ - New Service

Comm. 3/18/57


Date	Material	Amount	Total	Date	Amount
12-3-57	Labor	1.65		11-28-56	Deposit \$ 50.00
	10% O.H.	.17	1.82	3-18-57	Refund \$ 18.29
	55' 3/4" Copper tubing @.4396		24.18		\$ 31.71
	1 3/4" C x 1/2 I.W.H. Stop & Waste		4.96		NON CHARGE
	1 hr. Trucking @.75		.75	12-3-56	Labor
			31.71		1 1/2 Straight tailpiece .50
					1 1/2 Offset tailpiece .50
					1.00
					35' 3/4" Copper tubing @.375 13.13
					1 3/4" C Corp Cock 5.94
					1 3/4" C Curb Cock 4.64
					1 Box & Rod 4.62
					(Service installed by Cont.) 29.33

TOWN OF LEXINGTON — BOARD OF PUBLIC WORKS

WATER DIVISION

DATE _____

Sketch of Service Here

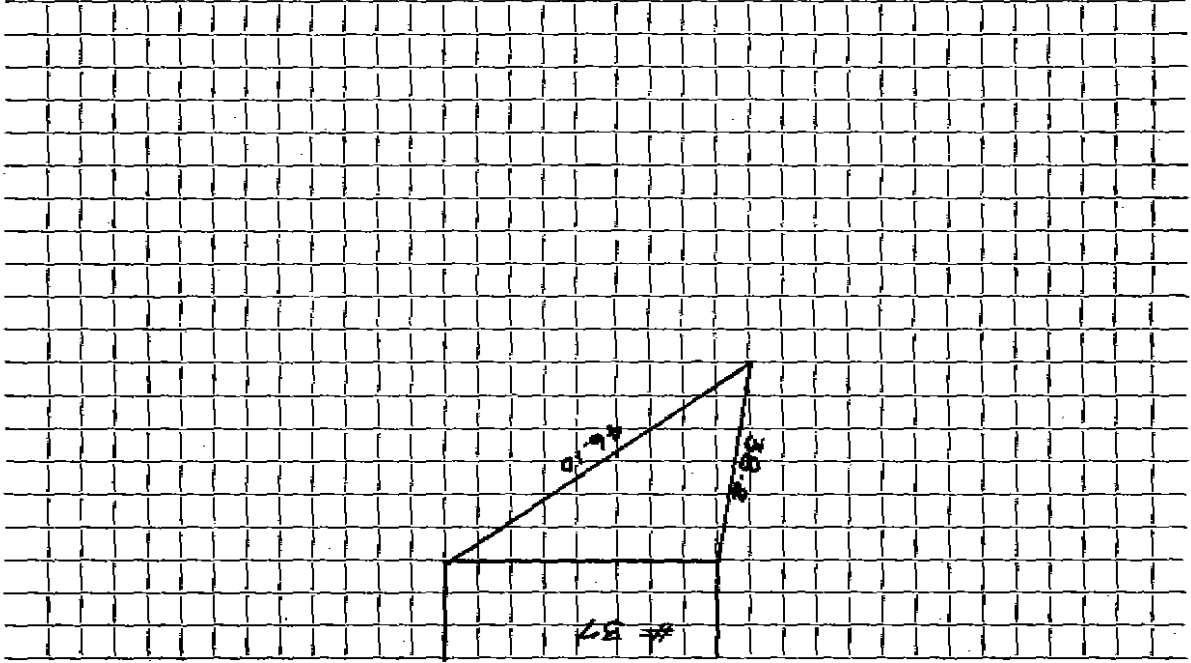

Connection made in _____ Street. Work completed _____

Remarks: _____