

Name William Goodwin
 Address 38 Bernard Street
 Lexington, Mass.

Service No. 230
 2879

Locatic 38 Bernard Street

Kind of Pipe

Size

Size of Main

Repair—Renewal—New Service

Com. 11-6-50

Location

Date	Material	Amount	Total	Date	Amount
Aug. 28 '50	Labor	2 55	2 55	Aug 16 '50	35 00
	20% Overhead		26	11 10	9 45
	40' - 3/4" Copper Tubing @ .275	11 00			37 85
	1 - 3/4" x 1/2" I.W.H. 3/8"	3 29			
	Littlefield Shovel 2 hrs. @ 7.00	14 00		Aug. 28, '50 Labor	3 17
	Trucking 1 hr. @ .75	75	31 85	13' - 3/4" Copper Tubing @ .275	3 58
				1 - 3/4" Corp-cock	3 15
				1 - 3/4" x 3/4" Carb-cock	3 85
				1 - Box & Rod	3 35
				1 - 3" Offset Tail Piece	42
				1 - 1" Straight Tail Piece	42
				Littlefield Shovel 1 hr. @ 7.00	7 00
				Trucking 1 hr. @ .75	75
	Labor				<u>25 69</u>

Hradley Press, Inc., Lexington

DATE _____

TOWN OF LEXINGTON—BOARD OF PUBLIC WORKS

WATER DIVISION

The undersigned applies for a supply of water at No. _____ St. and hereby agrees to comply with the rules and regulations as now, or at any future time, established by the Board of Selectmen.

Am't. of Estimate \$ _____


Owner _____

Am't. Paid \$ _____

Address _____

Builder _____

Sketch of Service Here

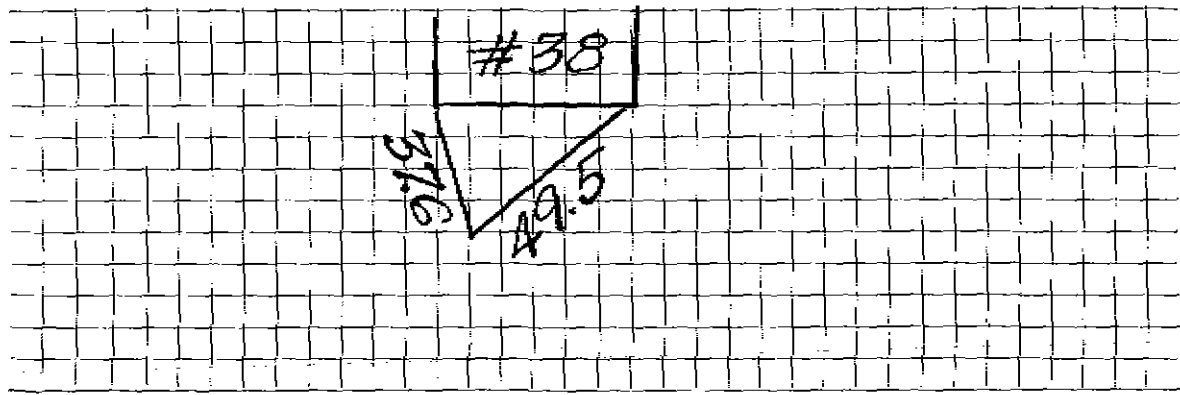

Connection made in _____ Street.

Work completed _____ 19

Remarks: