

WATER SERVICE RECORD

Name Eric Sahlberg

Service No. 75

Address 39 Bernard Street

Location

~~Repair~~ ~~Renewal~~ — New Service

Comm. 7/22/57


Date	Material	Amount	Total	Date	Amount
4/26/57	Labor	1 95		4-24-57	Deposit \$ 35 00
	10% overhead	20	2 15	7-22-57	Refund 10 23
	40' - 3/4" Copper tubing @	.4228	16 91		NON CHARGE 24 77
	1 - 3/4" Cx 1/2 I.W.H. Stop & Waste	4 96		1 - 1/2 Straight tailpiece	50
	1 Hr. Trucking		75	1 - 1/2 Offset tailpiece	50
			24 77		1 00
				33' 3/4" Copper tubing	375 12 38
				1 3/4" W Corp Cock	5 94
				1 3/4" C Curb Cock	4 64
				1 Box & Rod	4 62
					28 58
				Service installed by Cont.	

TOWN OF LEXINGTON — BOARD OF PUBLIC WORKS

WATER DIVISION

DATE _____

Sketch of Service Here

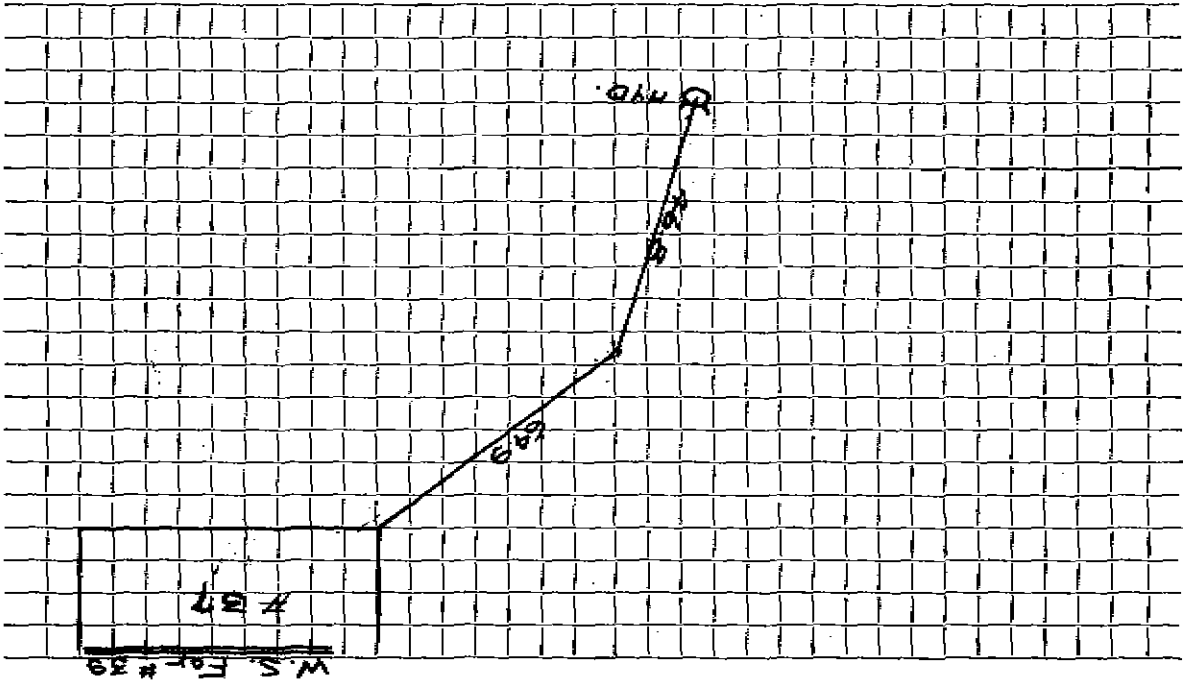

Connection made in _____ Street. Work completed _____

Remarks: _____

.....

.....