

WATER SERVICE RECORD

Name William H. Sullivan

Service No. 253

Address 40 Bernard Street

Location

REPAIR WORK - New Service

Com. 10-5-53


Date	Material	Amount	Total	Date	Amount
9/9/53	Labor	1 75		9-26-53	25 00
	10% overhead	18	1 93	10-3-53	3 08
	42' - 3/4" copper tubing @.3629	15 24			21 92
	1 -3/4"C x 1/2" I.W.F. stop& waste	4 00			
	1 hr. trucking		75	9/9/53	1 75
			21 92	9' -3/4" copper tubing@.3629	3 27
				1 -3/4"C. corp-cock	4 33
				1 - 3/4"C x 3/4 "C. curb-cock	4 67
				1 box and rod	3 90
				1 -1/2"straight tail piece	50
				1 -1/2"offset tail piece	50
				1 hr. trucking	75
					19 67

DATE _____

TOWN OF LEXINGTON — BOARD OF PUBLIC WORKS

WATER DIVISION

Sketch of Service Here

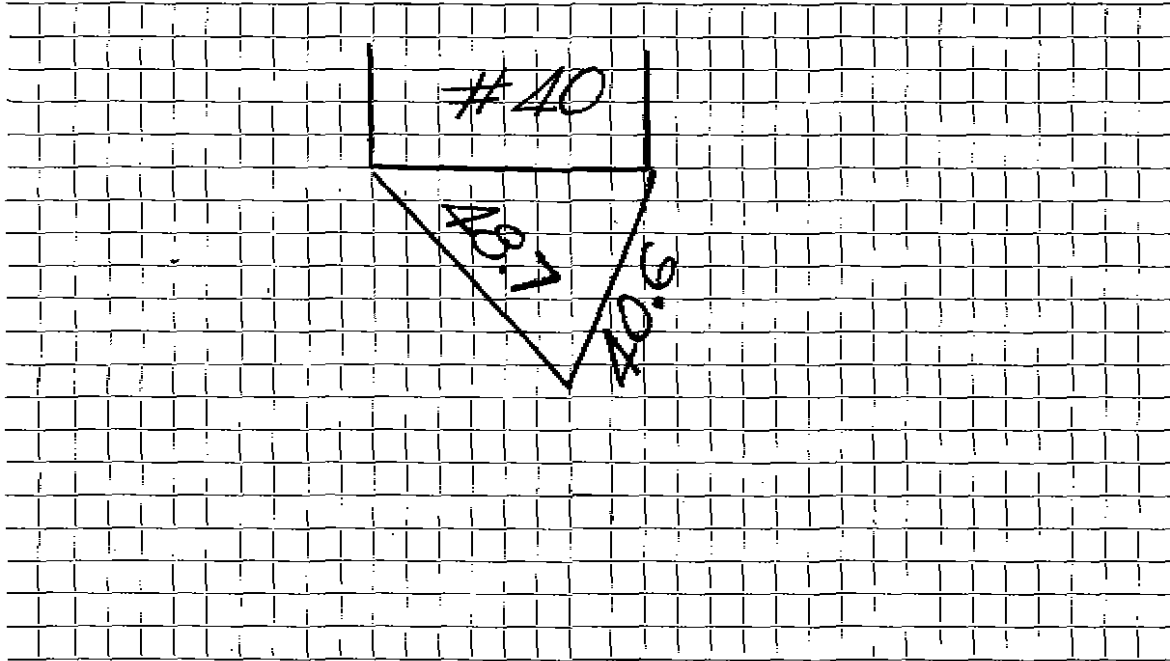

Connection made in _____ Street. Work completed _____

Remarks: _____

