




DATE \_\_\_\_\_

TOWN OF LEXINGTON — BOARD OF PUBLIC WORKS

WATER DIVISION

Sketch of Service Here

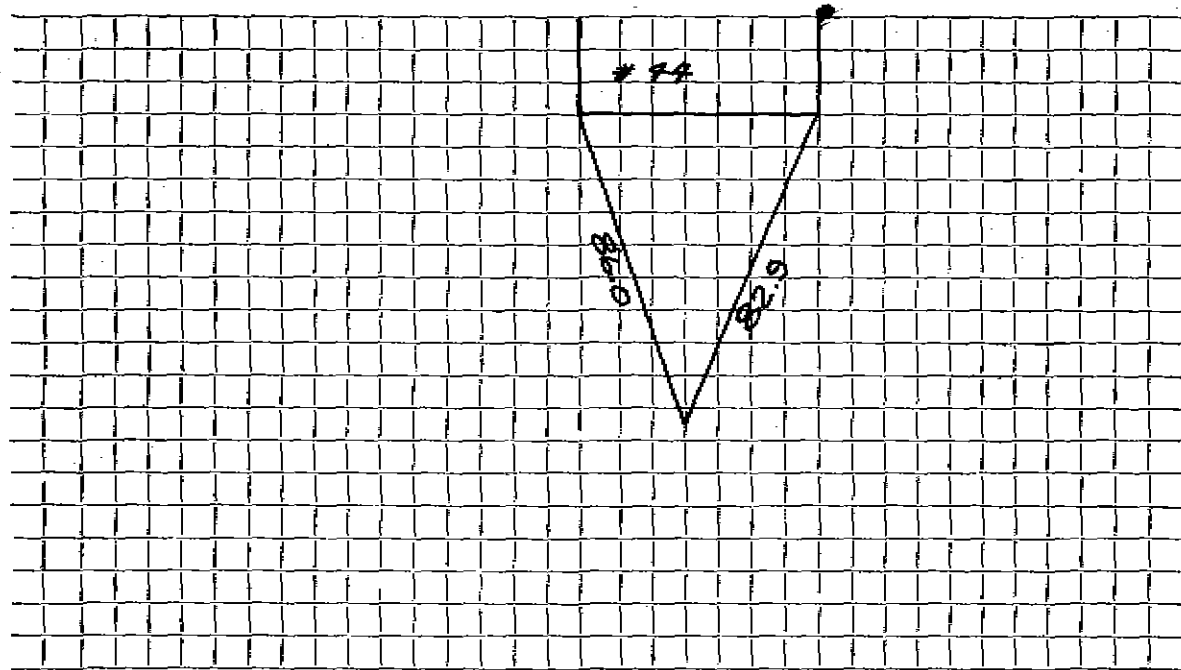

W.S. For # 43  
Lot # 196

Connection made in ..... Street. Work completed .....

Remarks: .....

.....

.....