

WATER SERVICE RECORD

#5158

Name William H. Sullivan

Service No. 81

Address 44 Bernard Street

Location

~~Repair~~ New Service

COM. 7-19-54


Date	Material	Amount	Total	Date	Amount
5/26/54	Labor	2 00		4-15-54	Deposited 25 00
	10% overhead	20	2 20	7-20-54	Refunded* 20
	51' - 3/4" copper tubing @	.35	17 85		NON CHARGE 24 80
	1 - 3/4" C x 1/2" I.W.H. stop & waste	-4 00		5/26/54	Labor 2 00
	1 hr. trucking		75	17' - 3/4" copper tubing @	.35 5 95
			24 80	1 - 3/4" C. corp-cock	4 33
				1 - 3/4" C x 3/4" C. curb-cock	4 67
				1 box and rod	3 90
				1 - 1/2 straight tail pc.	50
				1 - 1/2 offset tail pc.	50
				1-2/3 hrs. Littlefield shovel @	7.50-12.50
				1 hr. trucking	75
					<u>35 10</u>

* not made payable to town
to apply on C. H. & #57

DATE _____

TOWN OF LEXINGTON — BOARD OF PUBLIC WORKS
WATER DIVISION

Sketch of Service Here

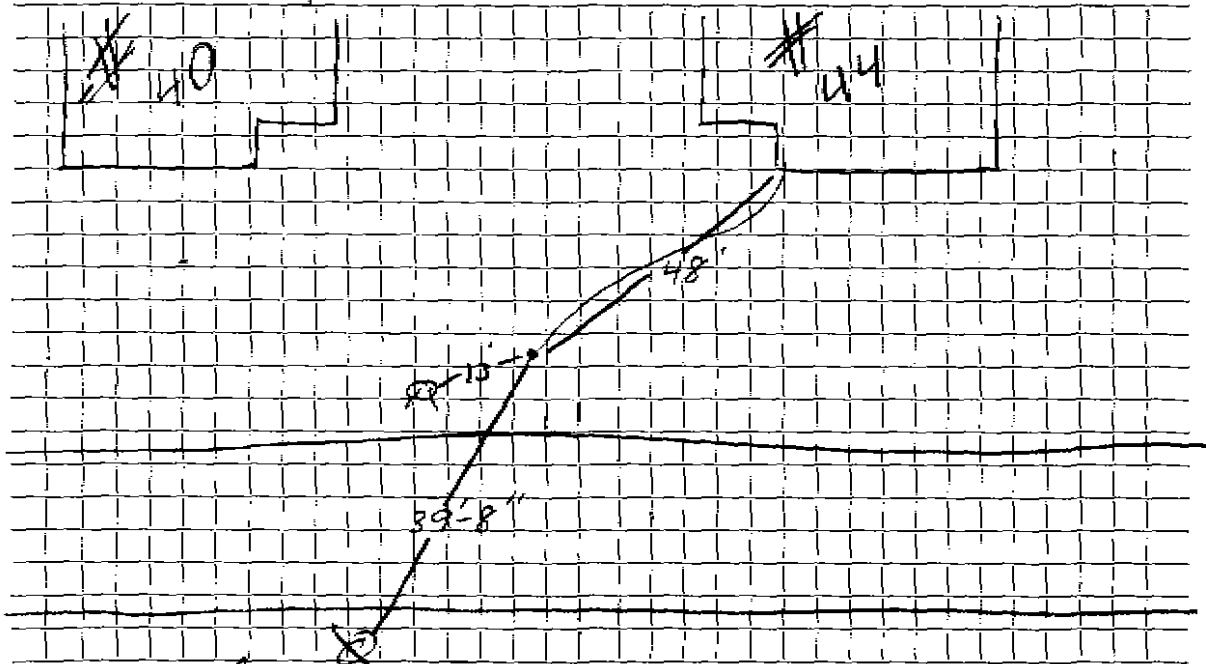

Connection made in Bernard 24/3 Street. Work completed

Remarks:
.....
.....