




TOWN OF LEXINGTON — BOARD OF PUBLIC WORKS

WATER DIVISION

DATE

Sketch of Service Here

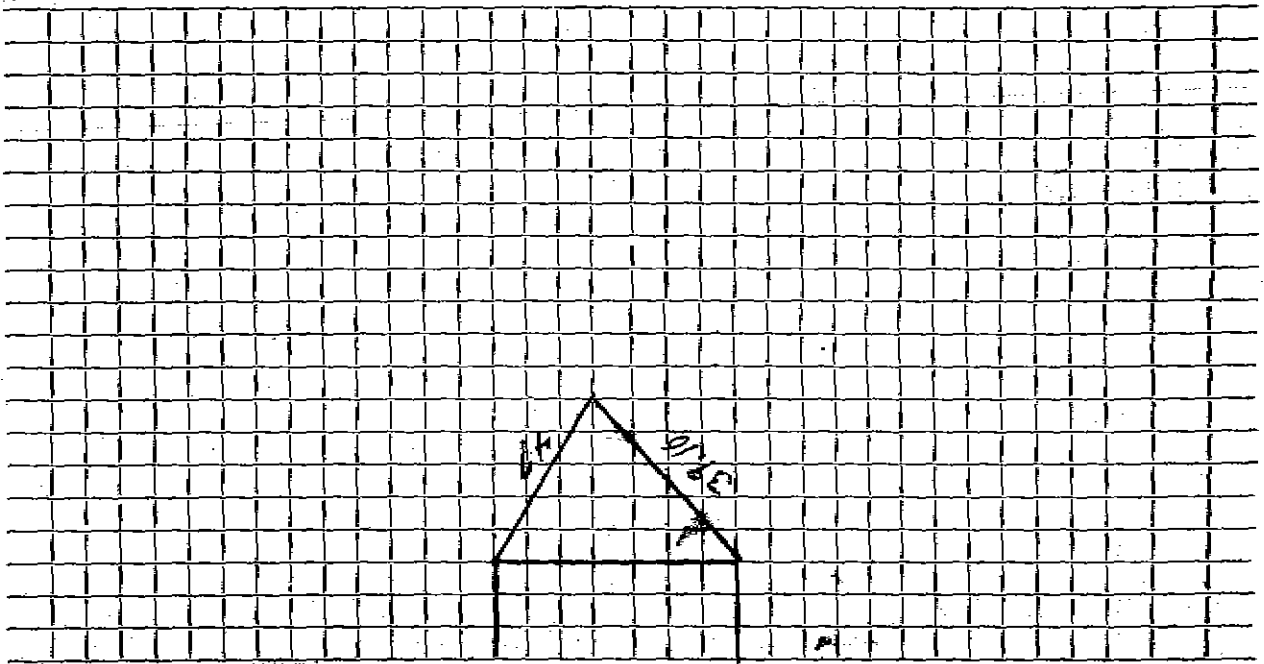

Street. Work completed

Connection made in

Remarks: