

## WATER SERVICE RECORD

Name Donald Irwin

Service No. 101

Address 7 Bernard Street

Location

~~Repair - Renewal~~ - New Service

Comm 8-3-59


Date	Material	Amount	Total	Date	Amount	
6-3-59	Labor	3.86		6-25-59	Deposit	50.00
	10% O.H.	.39	4.25	8-3-59	Retard	21.43
47'	3/4" Copper tubing @.3764	17.69				28.57
1	3/4" C x 1/2 I.W.H. Stop & Waste	5.88			NON CHARGE	
1	hr. Trucking @.75	.75			Labor	2.14
			28.57			
				30'	3/4" Copper tubing @.3764	11.29
				1	3/4" C Corp Cock	4.67
				1	3/4" C Curb Cock	6.00
				1	Box & Rod	5.00
				1	1/2 Straight tailpiece	.50
				1	Offset Tailpiece	.50
						30.17

DATE \_\_\_\_\_

TOWN OF LEXINGTON — BOARD OF PUBLIC WORKS

WATER DIVISION

Sketch of Service Here

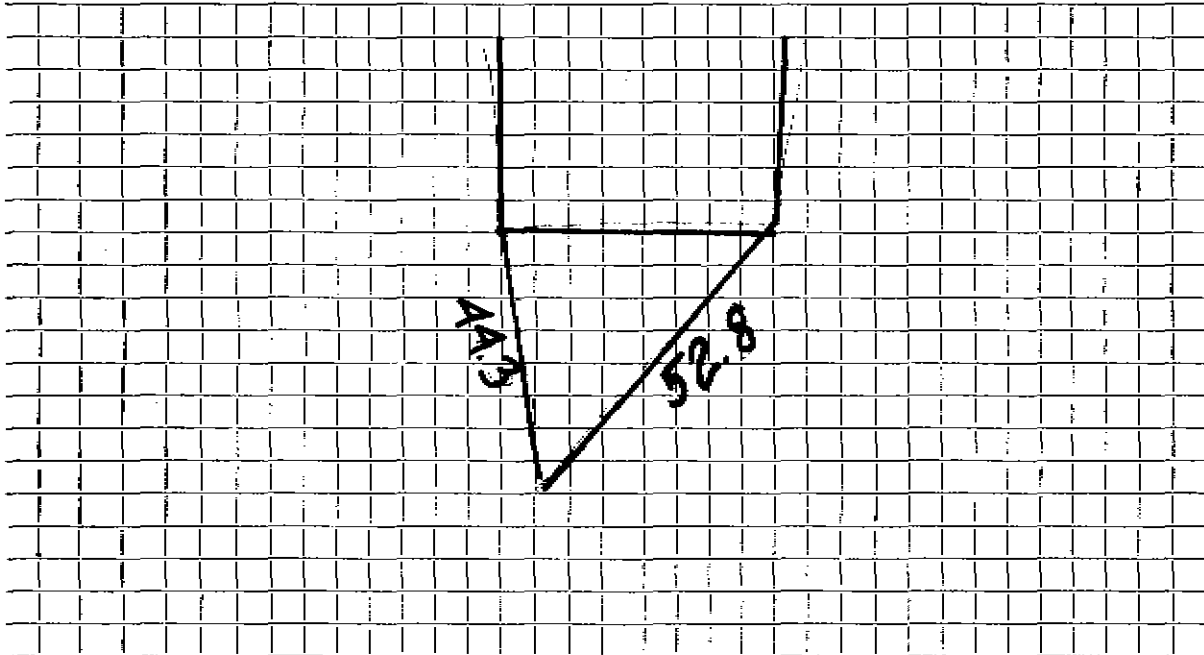

Connection made in ..... Street. Work completed .....

Remarks: .....  
.....  
.....