

Name Ellen G. O'Donnell

Service No. ~~24~~ 244

Address ~~2115 Ave. Medford~~
#9 Bernard St.

Location Cor. Bernard & Ivan St.

Kind of Pipe

Size

Size of Main

~~Repair - Blow work~~ - New Service

Location

Date	Material	Amount	Total	Date	Amount
Comm. 27.2 7-16-32	40' 1" C.L. Pipe @.27	\$10 80		July 29	Cash 27 00
	2 1" L.L. Coup. @.25	50		July 26	Cash 75
	1 1" L.L. Ell	30			
	Trucking	75			
	1 S & W	3 00	\$15 35		
7/19/32	7 Hrs. Labor @.55	3 85			
	3 " " @.60	1 80	5 65		
	15% Overhead		85		
	<u>Cost</u>		21 85		
	<u>CHARGE</u> - Amount of estimate	\$27 75	\$27 75		
	Labor				

Radley Press, Inc., Washington

DATE July 15, 1932

TOWN OF LEXINGTON—BOARD OF PUBLIC WORKS

WATER DIVISION

The undersigned applies for a supply of water at No. Cor. Bernard & Swan Sts. and hereby agrees to comply with the rules and regulations as now, or at any future time, established by the Board of Selectmen.

Am't. of Estimate \$ 27⁷⁵


Owner Ellen G. Bonnell

Am't. Paid \$ 27⁷⁵

Address 7. Ellis Ave.
Medford Mass

Builder _____

Sketch of Service Here

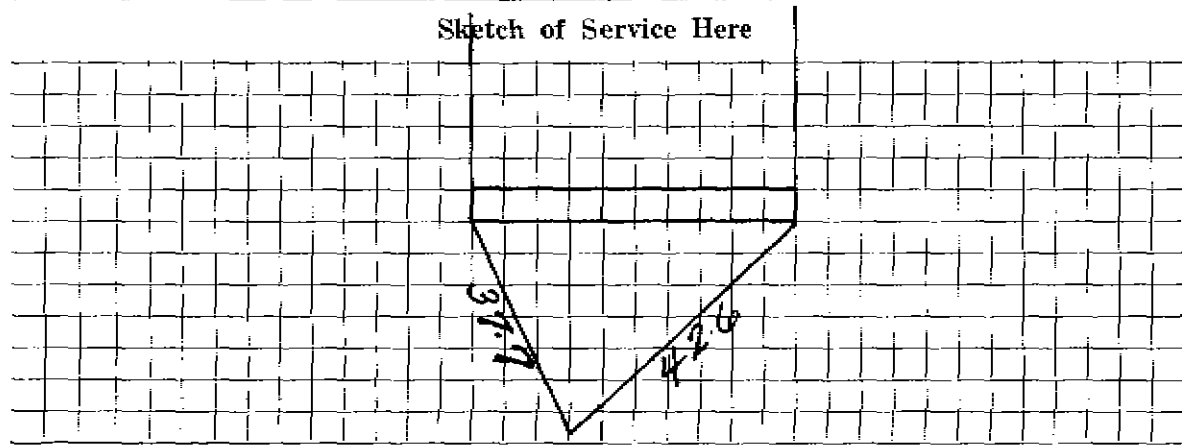

Connection made in _____ Street. Work completed _____ 19

Remarks: