

DATE July 9, 1930

TOWN OF LEXINGTON—BOARD OF PUBLIC WORKS
WATER DIVISION

The undersigned applies for a supply of water at No. Car. Bestwell Rd. + Eaton St. and hereby agrees to comply with the rules and regulations as now, or at any future time, established by the Board of Selectmen.

Am't. of Estimate \$ _____

Owner Richard B. Parker


Am't. Paid \$ _____

Address 20 Prescott St.

Builder Mr. N. S. Corb.

Cambridge Mass.

Sketch of Service Here

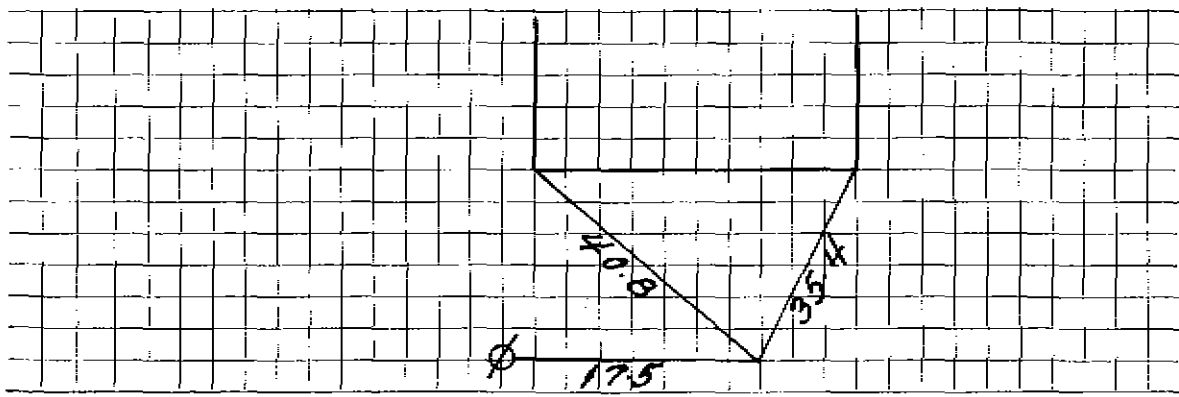

Connection made in _____ Street. Work completed _____ 19

Remarks:

[Handwritten notes and stamps in the bottom right corner, including a circular stamp with illegible text.]