

Name Innis & McLerman

Service No. ~~18~~ 273

Address Boston Road, Billerica, Mass.

104 Bertwell Road

5890

6441

Location 104 Bertwell Road

Kind of Pipe

Size

Size of Main

Repair—Renewal—New Service

Location

Date	Material	Amount	Total	Date	Amount
5/3/40	4 hrs. @ 60¢	2 40		April 29, 1940	20 00
Com 6/11/40	10% Overhead	24	2 64	June 11, 1940	6 98
	36' 3/4" Copper Tubing @ 18¢	6 48	6 48		13 02
	1 3/4" C. Union (3 Part)	90	2 25		
	1 3/4" C. x 1/2" I S. & W.	2 25	75		
	1 hr. trucking @ 75¢	75	13 02		
	Labor				

Hadley Press, Inc., Lexington

DATE April 25 1940

TOWN OF LEXINGTON—BOARD OF PUBLIC WORKS
WATER DIVISION

The undersigned applies for a supply of water at No. 104 Bestwell Rd St. and hereby agrees to comply with the rules and regulations as now, or at any future time, established by the Board of Selectmen.

Am't. of Estimate \$ 25 00


Owner James & M^c Lennan

Am't. Paid \$ _____

Address by L.F. Emerald
Bestwell Rd. Ballerica

Builder Robert Lohman

Sketch of Service Here

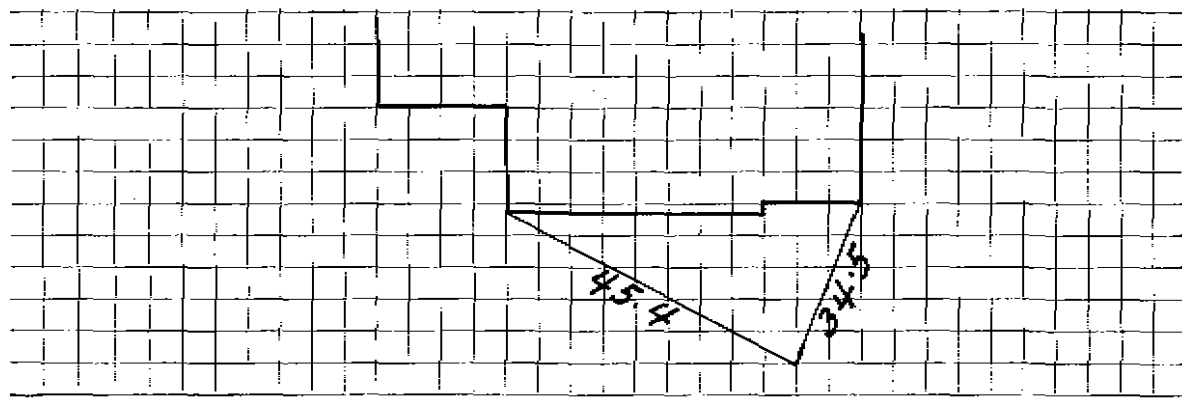

Connection made in _____ Street. Work completed _____ 19

Remarks: